



OFFICE OF THE
DOUGLAS COUNTY SURVEYOR

Station: TIDAL BM 15
Set By (Agency): NOS
Date Set: 1974
Recovered By JRL, SJF
Date Recovered 8/11/86
Recovered By _____
Date Recovered _____
Recovered By _____
Date Recovered _____

T 22 S, R 13 W, Sec 12

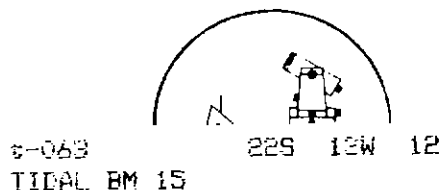

NAD 750656.37 3746302.14
83 45°40'33" 124°11'07"

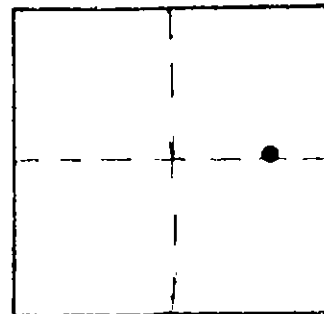

VERTICAL CONTROL

Elevation: 9.10 ft. Tidal
Precision: 3rd. NGS Line # Info. USGS Line # _____ OSHD Line # _____
Agency: NGS Proj. # _____ Date: 1986

HORIZONTAL CONTROL


South Zone State Plane Coordinates: Y(Northing) 753,691.36 X(Easting) 1,025,341.47
Precision: 1/25,000 Agency: DCSO Proj. # 2005-4 Date: 12/15/86
Approximate Geographic Position: Latitude 43°40'33" Longitude 124°11'07"

DESCRIPTION and TO REACH

A standard N.O.S. tidal disk stamped "TIDAL BM 15 1974" set flush in concrete cover of Windy Cove sewer pump station at the northeast corner of the intersection of 9th. Blvd and the Winchester Point road leading to the children's fort.

From the bridge on 9th. Blvd. crossing Winchester Creek in T22S, R12W, Sec. 7 proceed southwesterly along 9th. Blvd. approx. 0.4 miles to monument on right.

SKETCH

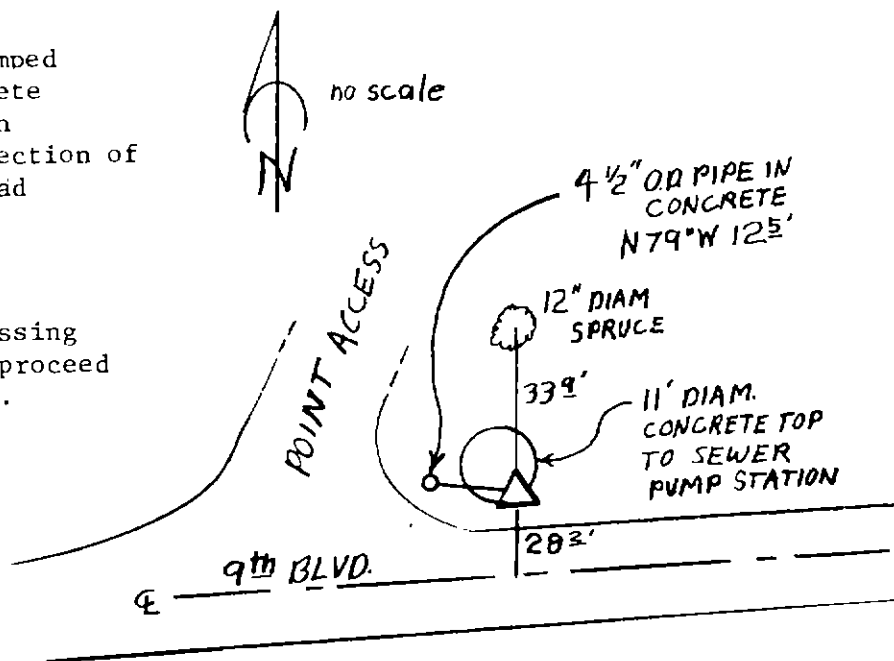

Reference Marks:

Note: For further information, contact the Douglas County Surveyor's Office, Room 205 Douglas County Justice Building, Roseburg, OR 97470. Phone 440-4278. Douglas County residents outside the Roseburg calling area, dial toll free 1-800-452-0991.