


OFFICE OF THE
DOUGLAS COUNTY SURVEYOR



p-011
P 444

NAD 716528.93 4134418.88
83 43°35'57" 123°16'52"

Station: P 444 T 23 S, R 5W, Sec 3
Set By (Agency): OSHD
Date Set: 1952
Recovered By RWS, SIF
Date Recovered 9/14/87
Recovered By _____
Date Recovered _____
Recovered By _____
Date Recovered _____

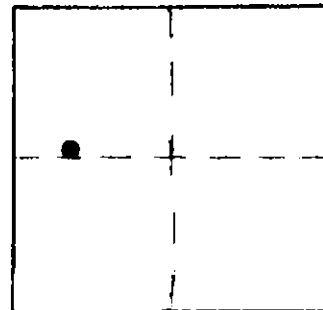

VERTICAL CONTROL

Elevation: 361.236 NGS Line # 6 USGS Line # _____ OSHD Line # _____
Precision: 1st Agency: USC&GS Proj. # _____ Date: 1957

HORIZONTAL CONTROL

South Zone State Plane Coordinates: Y(Northing) 716,563.61 X(Easting) 1,263,458.57
Precision: 1/15,000 Agency: DCSO Proj. # 2008 Date: 1979
Approximate Geographic Position: Latitude 43°35'57" Longitude 123°16'52"

DESCRIPTION and TO REACH



SKETCH

An OSHD disk stamped "P 444 1952" set on the north end of the bottom step of a concrete stairway leading to the east side of Yoncalla City Hall and Library.

TO REACH:

YONCALLA
CITY HALL AND LIBRARY

At the intersection of Applegate Ave. and State Hwy. 99 in T23S, R5W, Sec. 3, monument is northwest of intersection.

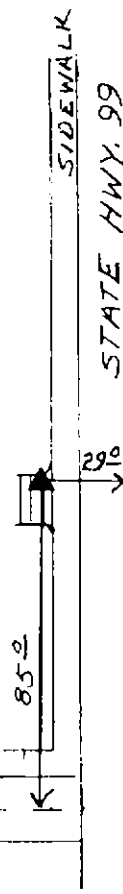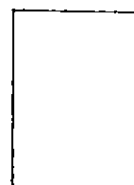

Reference Marks:

SIDEWALK
APPLEGATE AVE.

Note: For further information, contact the Douglas County Surveyor's Office, Room 205 Douglas County Justice Building, Roseburg, OR 97470. Phone 440-4278. Douglas County residents outside the Roseburg calling area, dial toll free 1-800-452-0991.