


OFFICE OF THE  
DOUGLAS COUNTY SURVEYOR

m-004  
M-451

23S 5W 11

NAD 712769.63 4192581.08  
83 43°35'22" 123°15' 3"

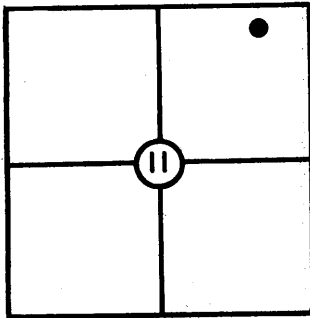

M-004

T 23 S, R 5W, Sec. 11

Station: M-451

Set By (Agency): OSHD

Date: 1953

VERTICAL CONTROL

NGVD 29 438.21

Elevation: ~~438.211~~ NGS(USC&GS) Line # \_\_\_\_\_ OSHD USGS Line # 369

Order Of Precision 3rd Agency: OSHD Proj. #: \_\_\_\_\_ Date: 1956 adj.

HORIZONTAL CONTROL

OCS 27


Oregon State Plane Coordinates: Y(Northing) 712,804.20 X(Easting) 1,271,620.85  
(South Zone)

Order Of Precision 1/25,000 Agency: DCSO Proj. #: 2010-6 Date: 1978

Approximate Geographic Position: Latitude= 43° 35' 23" <sup>CS 60/23</sup> Longitude= 123° 14' 59"

DESCRIPTION: An OSHD bench mark brass cap,  
marked "M-451 " set on the top of the SE cor.  
of a retaining wall of a single-lane freeway  
overcrossing structure, approx. 2 ft. lower  
than the roadway.

SKETCH

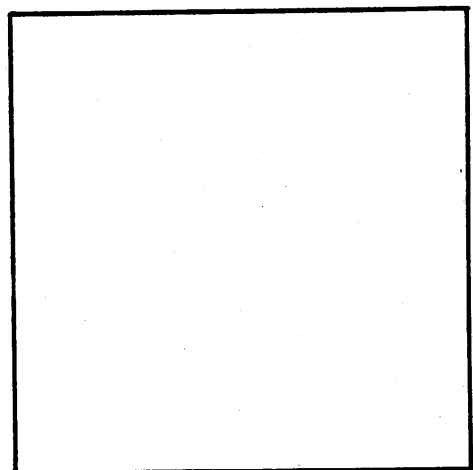

VICINITY: Approx. 2.3 mi. N. of Yoncalla-

Drain Exit #150 along I-5.

NOTE: For Possible Further Information On This Station, Please Contact The Douglas County Surveyors Office, Rm. 205 Douglas County Justice Bldg., Roseburg, OR. 97470 Phone 672-3311 Ext. 272.. Douglas County residents outside the Roseburg calling area dial toll free 1-800-452-0991.