

OFFICE OF THE
DOUGLAS COUNTY SURVEYOR

Station: S 1/4 T 23 S, R 7W , Sec 3

Set By (Agency): LS 307

Date Set: _____

Recovered By _____



Date Recovered 1/72

Recovered By JMP

Date Recovered _____

Recovered By _____

Date Recovered _____

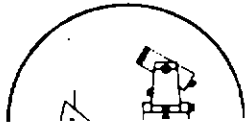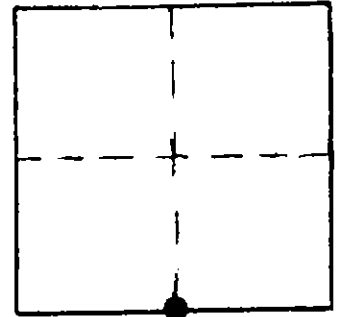

230-07W 02-004 230 07W 02
5 1/74

440 71607.91 412222.43
13 43°35'31" 123°30'47"

VERTICAL CONTROL

Elevation: _____ NGS Line # _____ USGS Line # _____ OSHD Line # _____

Precision: _____ Agency: _____ Proj. # _____ Date: _____

HORIZONTAL CONTROL

South Zone State Plane Coordinates: Y(Northing) 716,081.91 X(Easting) 1,201,962.55

Precision: 1/5,000 Agency: DCSO Proj. # 2006 Date: 1974

Approximate Geographic Position: Latitude 43°35'32" Longitude 123°30'47"

DESCRIPTION and TO REACH

SKETCH

Found: Brass cap stamped "LS 307 T23S R7W $\frac{3}{10}$ "
For more information see Douglas Co. record
of Corner Renewals.

Reference Marks:

Note: For further information, contact the Douglas County Surveyor's Office, Room 205
Douglas County Justice Building, Roseburg, OR 97470. Phone 440-4278. Douglas
County residents outside the Roseburg calling area, dial toll free 1-800-452-0991.