

2/82

OFFICE OF THE

m-001
M-266

24S 5W 29

DOUGLAS COUNTY SURVEYOR


NAD 665277.60 4170891.62
83 43°27'27" 123°19'36"

T 24 S, R 5W, Sec. 29

Station: M-266

Set By (Agency): USC & GS

Date: 1934

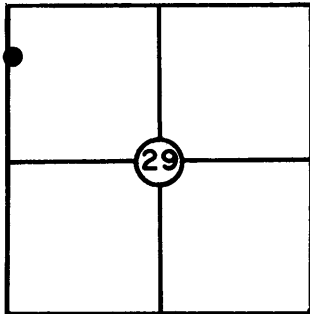

VERTICAL CONTROL

NGVD 29 455.13
Elevation: ~~455.125~~ OSHD NGS(USC&GS) Line # 369 USGS Line #

Order Of Precision 3rd Agency: OSHD Proj. #: Date: 1977

HORIZONTAL CONTROL

OCS 27
Oregon State Plane Coordinates: Y(Northing) 665,311.98 X(Easting) 1,249,932.12
(South Zone)


Order Of Precision 1/25,000 Agency: DCSO Proj. #: 2010-4 Date: 1978
(C.S. 59/47)

Approximate Geographic Position: Latitude= 43° 27' 27" Longitude= 123° 19' 32"

DESCRIPTION: A standard brass cap set
in S'thly end of a concrete headwall approx.
16 ft. W. of centerline & approx. 50 ft. S.
of utility pole #3-307. Cap marked "BM No.
M-266 1934" From the Metz Hill interchange
proceed W'stly along Metz Hill Rd. (Co. Rd.
#74) 0.1 mi. to intersection, turn lt. go
0.2 mi. on Co. Rd. No.74A to monument on rt.

VICINITY: Metz Hill interchange along I-5.

SKETCH

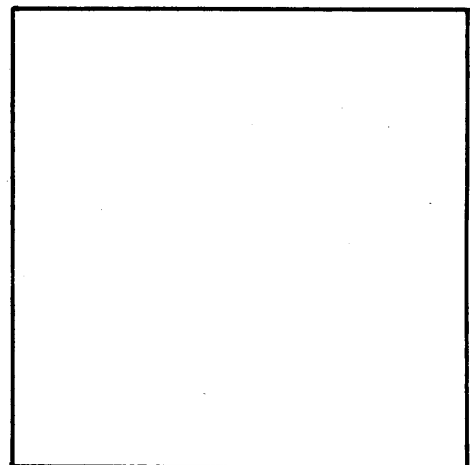

NOTE: For Possible Further Information On This Station, Please Contact The Douglas County Surveyors Office, Rm. 205 Douglas County Justice Bldg., Roseburg, OR. 97470 Phone 672-3311 Ext. 272.. Douglas County residents outside the Roseburg calling area dial toll free 1-800-452-0991.