

OFFICE OF THE
DOUGLAS COUNTY SURVEYOR

Station: X-028

T 24 S, R 6W , Sec 29

Date Set: 1991

Set By (Agency): DCSO

Date Recovered: 8-23-91



Recovered By: LEM, JP

Date Recovered: _____

Recovered By: _____

Date Recovered: _____

Recovered By: _____

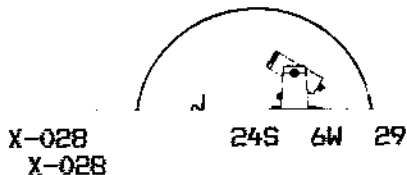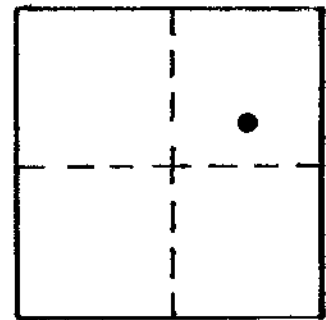

NAD 666124.39 4143046.28
83 43°27'25" 123°25'54"

VERTICAL CONTROL

Elevation: 826.2 NGS Line # _____ USGS Line # _____ OSHD Line # _____

Precision: GPS Agency: DCSO Proj. # 2008 Date: 1991

HORIZONTAL CONTROL

South Zone O.C.S. 27: Y(Northing) 666,158.80 X(Easting) 1,222,086.92

South Zone O.C.S. 83: Y(Northing) _____ X(Easting) _____

Precision: 1/25,000 Agency: DCSO Proj. # 2008 Date: 1991


Approx. NAD 83 Geographic Position: Latitude _____ Longitude _____

DESCRIPTION and TO REACH

SKETCH

SET: A standard DCSO disk stamped "X028 1991" set in
a 8" dia. concrete filled bellfile, protruding
8" from the ground.

To Reach: From the intersection of I-5 and St. Hwy
138 go westerly along St. Hwy. 138 approx.
7.5 mi. to mon. on the right. (at MP 17.05)
Mon. is situated approx. 600' east of inter-
section of Green Valley Rd. (Co Rd. #23).
Near R/W fence on cut bank approx. 4 ft.
above Rd. surface.

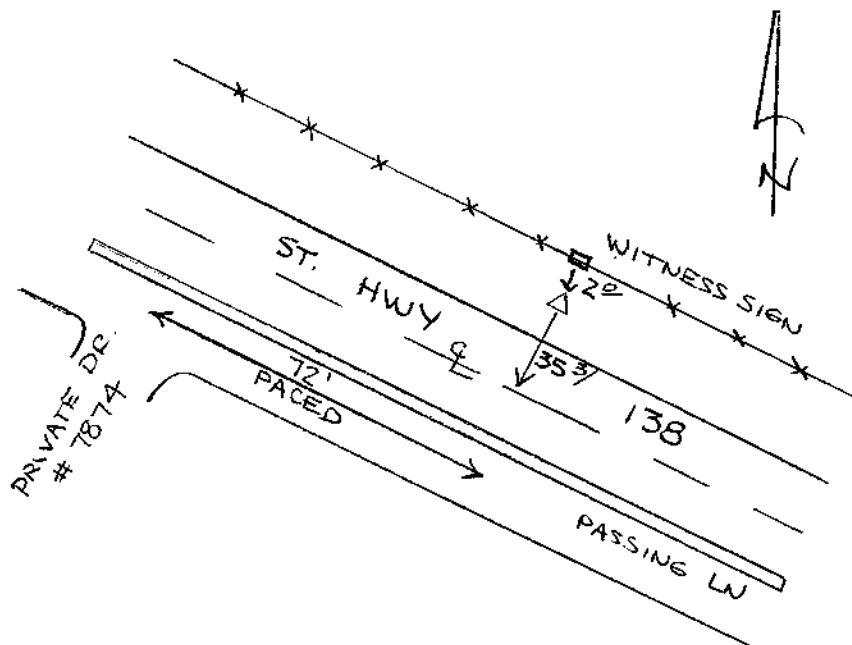

Reference Marks:

Note: For further information, contact the Douglas County Surveyor's Office, Room 205
Douglas County Justice Building, Roseburg, OR 97470. Phone 440-4278. Douglas
County residents outside the Roseburg calling area, dial toll free 1-800-452-0991.