

Douglas County Geodetic Data Sheet


T 25 R 05 S 04

Station: L 10

Designation: L-002

Date Set: 1917 Set By (Agency): USGS

Last Date Recovered: 09/00/1993

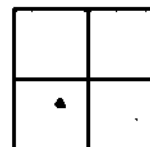

VERTICAL CONTROL

NGVD 29 Elevation: 430.173 Feet

Precision: 1ST ORDER Agency: USC&GS

Project: Date: 1957

NAVD 88 Elevation: 132.189 Meters

Precision: 1ST ORDER Agency: USGS

Project: Date: 1988

NGS Line #

USGS Line #

OSHD Line #

File #

HORIZONTAL CONTROL

OCS 27 Y(Northing): 652,114.56 X(Easting): 1,256,720.07 Lat Long:

Precision: 1/25,000 Agency: DCSO Project: 2006 Date: 1981

OCS 83 Y(Northing): 652,080.03 X(Easting): 4,177,679.39 Lat: 43°25'18" Long: 123°17'58"

Precision: Agency: Project: Date:

OCS 83/91 Y(Northing): X(Easting): Lat: Long:

Precision: Agency: Project: Date:


OCS 27 Scaled Latitude: 43°25'19" OCS 27 Scaled Longitude: 123°17'54"

DESCRIPTION:

A 4 INCH DIAMETER USGS DISK STAMPED; PRIM TRAV STA NO9 429 L 10 B 1903 1917; SET IN CONCRETE APPROX 2 INCHES BELOW MOWN LAWN SURFACE.

COMMENTS:

GO TO THE INTERSECTION OF STATE HWY 99 AND LOCUST ST IN T25S R5W SEC 4 - IN OAKLAND. MONUMENT IS WESTERLY OF INTERSECTION IN SMALL PARK.

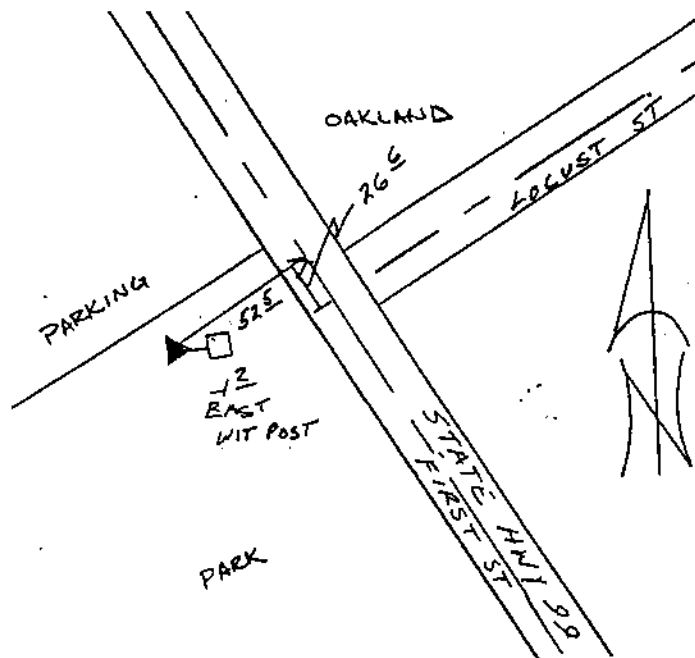

Note: For further information contact the Douglas County Surveyors Office, Room 105A Douglas County Courthouse, Roseburg, OR 97470. Phone 440-4272 or Fax (541)957-8150. Douglas County Residents outside Roseburg calling area, dial toll free 1-800-224-1619.