


DOUGLAS COUNTY SURVEYOR

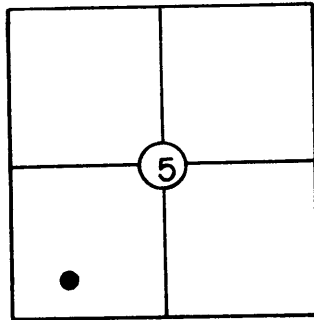

H-012

VERTICAL CONTROL

NGVD 29

Elevation: 514.580 NGS(USC&GS) Line # ~~OSHD~~ ~~USGS~~ Line # 369

Order

Of Precision 3rd Agency: OSHD Proj. #: Date: 1977HORIZONTAL CONTROL

NAD 27

Oregon State Plane Coordinates: Y(Northing) 652,103.88 X(Easting) 1,250,815.21
(South Zone)


(Calapooya)

Order

Of Precision 1/25,000 Agency: DCSO Proj. #: 2006 Date: 1981Approximate Geographic Position: Latitude= 43° 25' 17" Longitude= 123° 19' 14"

DESCRIPTION: Station mark is a standard OSHD
brass cap stamped "H 677 1977", Station mark
is at the N.W. corner of (County Road #23)
concrete overpass structure over I-5 set in
bridge curb.

SKETCH

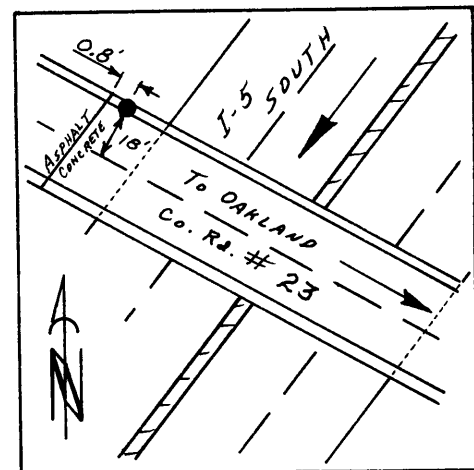

VICINITY: 1 mile WSW of Oakland, County
Road overpass I-5

NOTE: For Possible Further Information On This Station, Please Contact The Douglas
County Surveyors Office, Rm. 205 Douglas County Justice Bldg., Roseburg, OR.
97470 Phone 672-3311 Ext. 272.. Douglas County residents outside the
Roseburg calling area dial toll free 1-800-452-0991.