


OFFICE OF THE
DOUGLAS COUNTY SURVEYOR

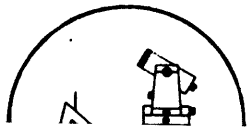


250-05W-07-018 25S 05W 07
NW CORNER

NAD 651019.43 4165081.92
83 43°25' 4" 123°20'48"

Station: NW CORNER
Set By (Agency): DCSO
Date Set: ~~1972~~ 1999
Recovered By LEM
Date Recovered 1981
Recovered By _____
Date Recovered _____
Recovered By _____
Date Recovered _____

PLSS PLS PLS100600
T 25 S, R 5W , Sec 7

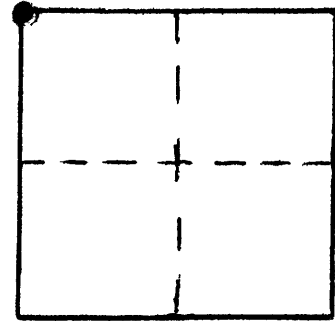

VERTICAL CONTROL

Elevation: _____ NGS Line # _____ USGS Line # _____ OSHD Line # _____
Precision: _____ Agency: _____ Proj. # _____ Date: _____

HORIZONTAL CONTROL **NAD 27**

South Zone State Plane Coordinates: Y(Northing) _____ X(Easting) _____
Precision: 1/5,000 Agency: DCSO Proj. # M131-50 CALAPOOYA (2008) Date: ~~1981~~ 1999
Approximate Geographic Position: Latitude 43° 25' 04" Longitude 123° 20' 44"

DESCRIPTION and TO REACH

SKETCH

Set brass cap. See Douglas County
Surveyor's Records of Government
Corners Renewed.

See unfiled Calapooya flood study control
survey files for tie info.

See survey M131-50 for corrected corner location

Reference Marks:

Note: For further information, contact the Douglas County Surveyor's Office, Room 205
Douglas County Justice Building, Roseburg, OR 97470. Phone 440-4278. Douglas
County residents outside the Roseburg calling area, dial toll free 1-800-452-0991.