

Set By (Agency): OSHD

Date Set: 1975

Recovered By RWS,TF


Date Recovered 4/13/87

Recovered By _____


Date Recovered _____

Recovered By _____

Date Recovered _____

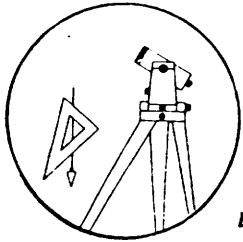

E-029

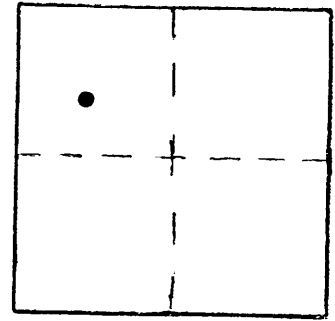

NGVD 29

VERTICAL CONTROL

Elevation: 559.00 NGS Line # _____ USGS Line # _____ OSHD Line # 369

Precision: 3rd Agency: OSHD Proj. # _____ Date: 1977

HORIZONTAL CONTROL CORPSCON6 NAVD88 562.56 FT.

South Zone State Plane Coordinates: Y(Northing) 681614 X(Easting) 4173172

Precision: GIS SCALED Agency: DCSO Proj. # _____ Date: 2014

Approximate Geographic Position: Latitude 43°30'08" Longitude 123°19'08"

DESCRIPTION and TO REACH

SKETCH


AN OSHD disk stamped "EE 666 1975"
set in the northeast corner of a
6 ft.X 4 ft. concrete headwall.

**Abridged version
keyed into SARS.**

From the Metz Hill Rd. (Co.Rd.#74)
overcrossing of I-5 (Exit #142) in
T24S,R5W,Sec.29, proceed northerly
along I-5 3.05 miles to monument on
right.

From the Rice Valley (Co.Rd.#30) over-
crossing of I-5 (Exit #146) in T24S,
R5W,Sec.5, proceed southerly along I-5
1.10 miles to monument on left (across
north bound lanes of I-5).

Reference Marks:

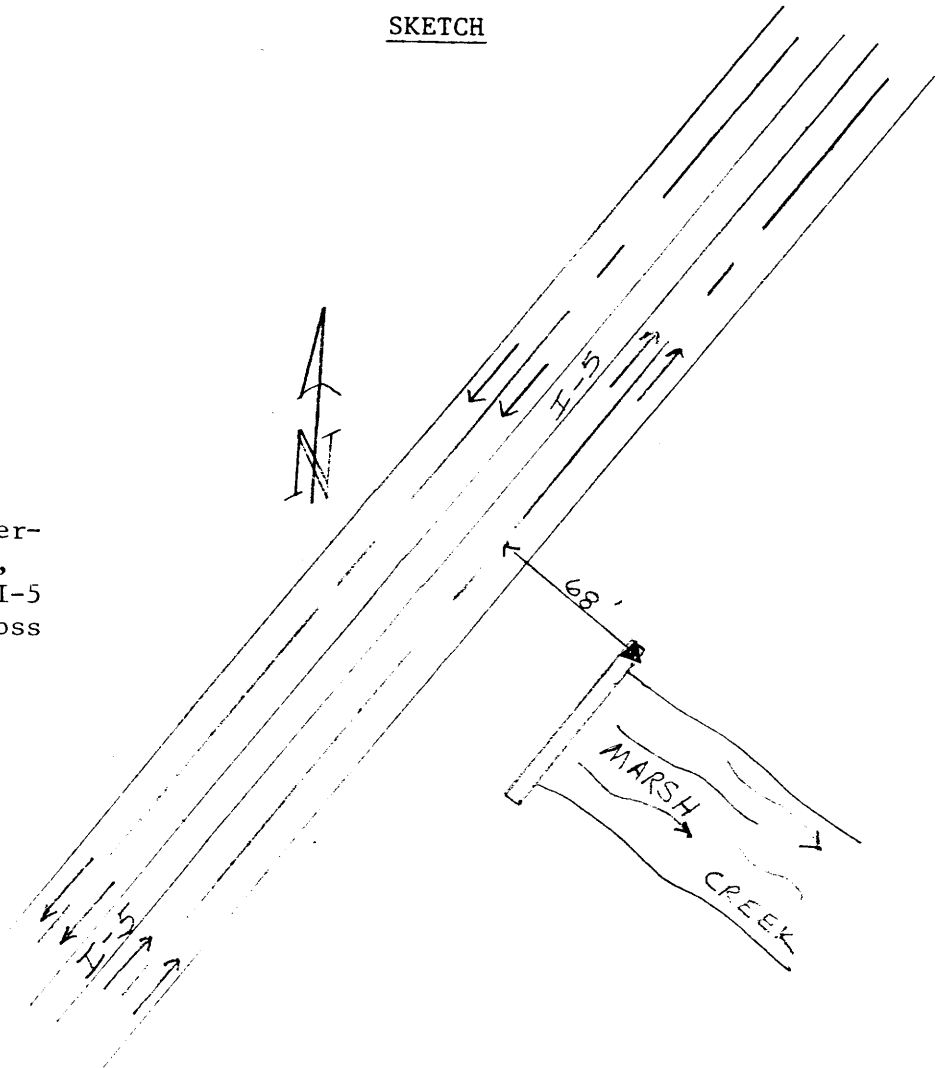

Note: For further information, contact the Douglas County Surveyor's Office, Room 205
Douglas County Justice Building, Roseburg, OR 97470. Phone 440-4278. Douglas
County residents outside the Roseburg calling area, dial toll free 1-800-452-0991.