


PLS 100440
250-05W-18-025 25S 05W 18
W 1/4

OFFICE OF THE
DOUGLAS COUNTY SURVEYOR

NAD 643067.52 4164802.11
83 43°23'45" 123°20'49"

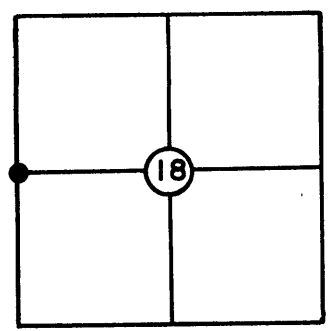

T 25 S, R 5W, Sec. 18
Station: W. 1/4 CORNER
Set By (Agency): DCSO
Date: 1999

VERTICAL CONTROL

Elevation: _____ NGS(USC&GS) Line # _____ USGS Line # _____

Order
Of Precision _____ Agency: _____ Proj. #: _____ Date: _____

HORIZONTAL CONTROL

^{NAD 27}
Oregon State Plane Coordinates: Y(Northing) _____ X(Easting) _____
(South Zone)

Order
Of Precision 1/5000 Agency: DCSO Proj. #: 0001 ^{M131-50}
~~6856/16~~ Date: 1999

Approximate Geographic Position: Latitude= 43° 23' 46" Longitude= 123° 20' 44"


DESCRIPTION: BRASS CAP ATTACHED TO IRON PIPE.

SEE DOUGLAS COUNTY SURVEYOR RECORD OF
GOVERNMENT CORNERS RENEWED.

See survey M131-50 for corrected corner
location.

VICINITY: _____

SKETCH

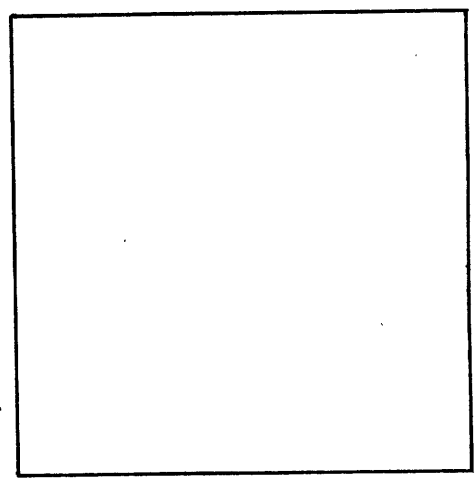

NOTE: For Possible Further Information On This Station, Please Contact The Douglas County Surveyors Office, Rm. 205 Douglas County Justice Bldg., Roseburg, OR. 97470 Phone 672-3311 Ext. 272. Douglas County residents outside the Roseburg calling area dial toll free 1-800-452-0991.