


OFFICE OF THE
DOUGLAS COUNTY SURVEYOR

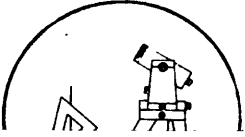

250-05W-21-020 25S 05W 21
SE CORNER

NAD 634550.76 4180558.92
83 43°22'26" 123°17'11"

Station: SE sec 21 T 25 S, R 5 , Sec 21

Set By (Agency): DCSO

PLSS 400300

Date Set: 1973

Recovered By _____


Date Recovered _____

Recovered By _____

Date Recovered _____

Recovered By _____

Date Recovered _____

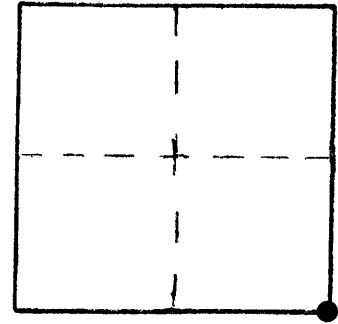

VERTICAL CONTROL

Elevation: _____ NGS Line # _____ USGS Line # _____ OSHD Line # _____

Precision: _____ Agency: _____ Proj. # _____ Date: _____

HORIZONTAL CONTROL NAD 27

South Zone State Plane Coordinates: Y(Northing) 634,585.68 X(Easting) 1,259,598.58

Precision: 1/5000 Agency: DCSO Proj. # CS 56/28 Date: 1973 1972

Approximate Geographic Position: Latitude 43°22'27" Longitude 123°17'07"

DESCRIPTION and TO REACH

SKETCH

SEE DCSO CORNER RENEWAL RECORDS.

COORD'S APPROXIMATE

1972 NAIL NOT FOUND
SET BC BY DCSO
1997

Reference Marks:

Note: For further information, contact the Douglas County Surveyor's Office, Room 205 Douglas County Justice Building, Roseburg, OR 97470. Phone 440-4278. Douglas County residents outside the Roseburg calling area, dial toll free 1-800-452-0991.