

P-122

OFFICE OF THE

DOUGLAS COUNTY SURVEYOR

Station: PEEL


T 26 S, R 3W, Sec 34

Date Set: 1999

Set By (Agency): DCSO


Date Recovered: 6-30-99

Recovered By: AIS SUT

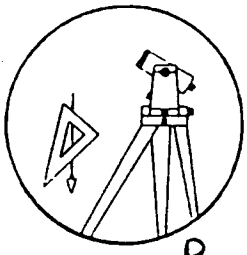

P-122

- Found
- New
- Reset
- Not Found
- Referenced
- Destroyed

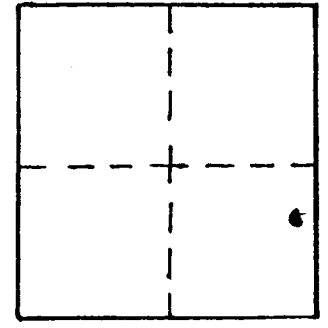

VERTICAL CONTROL

Elevation: 845.93 NGS Line # _____ USGS Line # _____ OSHD Line # _____

Precision: 3rd Agency: DCSO Proj. # 2007 Date: 1999

HORIZONTAL CONTROL CORPSCON6 NAVD88 849.51 FT. CS 66/56

South Zone O.C.S. 27: Y(Northing) _____ X(Easting) _____

South Zone O.C.S. 83: Y(Northing) 591650 X(Easting) 4247178

Precision: GIS SCALED Agency: DCSO Proj. # _____ Date: 2014

Approx. ^{DCS 27} ~~NAD 83~~ Geographic Position: Latitude 43°15'44" Longitude 123°01'47"

DESCRIPTION and TO REACH

DCSO BRASS CAP STAMPED "PEEL 1999"
SET IN CONCRETE FOOTING OF DEFUNCT
WEIGH STATION.

FROM THE INTERSECTION OF BUCKHORN ROAD
(CO. RD #17) AND LITTLE RIVER ROAD (CO. RD
#17C) IN T26S R3W, SEC 30, PROCEED
SOUTHWESTERLY 4.1 MILES ALONG LITTLE
RIVER ROAD TO MONUMENT ON LEFT

Reference Marks:

