



OFFICE OF THE
DOUGLAS COUNTY SURVEYOR

Station: NU-20 T 26 S, R 4 W, Sec 7
Set By (Agency): DCSO
Date Set: 1972
Recovered By RWS,SJF
Date Recovered 9/16/85
Recovered By _____
Date Recovered _____
Recovered By _____
Date Recovered _____

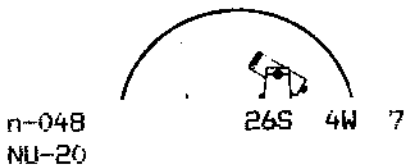

NAD 613471.60 4199339.59
83 43°19' 4" 123°12'48"

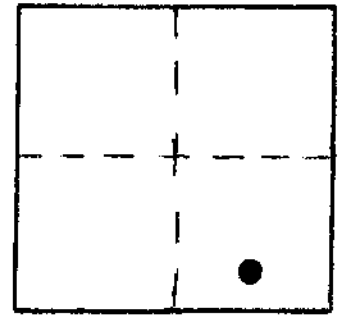

VERTICAL CONTROL NGVD 29

Elevation: 691.634 NGS Line # _____ USGS Line # _____ OSHD Line # _____
Precision: 2nd Agency: DCSO Proj. # 2006 Date: 1972

HORIZONTAL CONTROL OCS 27

South Zone State Plane Coordinates: Y(Northing) 613,506.87 X(Easting) 1,278,380.21
Precision: 1/25,000 Agency: DCSO Proj. # 2006 Date: 1972
Approximate Geographic Position: Latitude 43°19'05" Longitude 123°12'44"


DESCRIPTION and TO REACH

SKETCH

A DCSO disk stamped "NU-20 1972" set flush in rock outcrop.

TO REACH:

From the intersection of Diamond Lake Highway
(State Highway #138) and North Bank Road (Co.Rd. #200)
in T26S,R4W,Sec.12, proceed westerly along North Bank Rd.
approx. 7.2 miles to driveway and monument
on left.

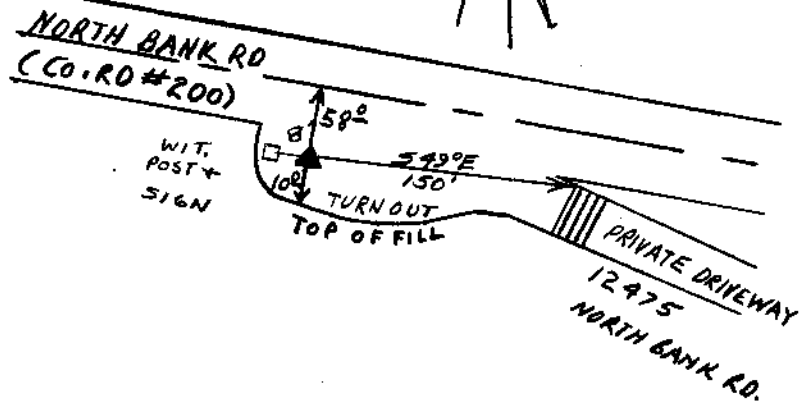

Reference Marks:

Note: For further information, contact the Douglas County Surveyor's Office, Room 205
Douglas County Justice Building, Roseburg, OR 97470. Phone 440-4278. Douglas
County residents outside the Roseburg calling area, dial toll free 1-800-452-0991.