


OFFICE OF THE

n-052  
NU-24

26S 4W 13

DOUGLAS COUNTY SURVEYOR

NAD 609177.87 4223126.22  
83 43°18'29" 123° 7'24"

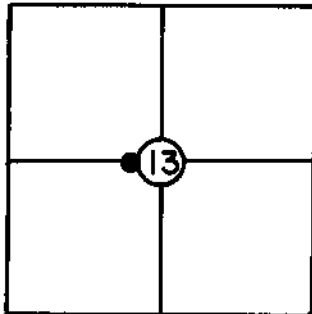

T 26 S, R 4W, Sec. 13

Station: NU-24

Set By (Agency): DCSO

Date: 1972

VERTICAL CONTROL

**NGVD 29**

Elevation: 675.741 NGS(USC&GS) Line # \_\_\_\_\_ USGS Line # \_\_\_\_\_

Order

Of Precision 2nd Agency: DCSO Proj. #: 2006 Date: 1972

HORIZONTAL CONTROL

**OCS 27**

Oregon State Plane Coordinates: Y(Northing) 609,213.35 X(Easting) 1,302,166.36  
(South Zone)

Order


Of Precision 1/25,000 Agency: DCSO Proj. #: 2006 Date: 1972

Approximate Geographic Position: Latitude= \_\_\_\_\_ Longitude= \_\_\_\_\_

DESCRIPTION: Bronze disk set in concrete

post, survey marker alongside, stamped "NU -  
24 1972" This disk is 30 ft. NE of <sup>NW</sup> ~~NE~~ end  
of Frear Bridge.

SKETCH

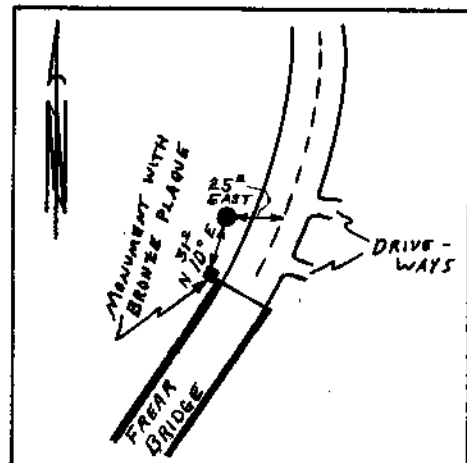

VICINITY: 0.4 mi. North from junction

of Wilbur-Glide cutoff & N. Umpqua Hwy. (Co. Rd. #200)

NOTE: For Possible Further Information On This Station, Please Contact The Douglas County Surveyors Office, Rm. 205 Douglas County Justice Bldg., Roseburg, OR. 97470 Phone 672-3311 Ext. 272. Douglas County residents outside the Roseburg calling area dial toll free 1-800-452-0991.