



OFFICE OF THE  
DOUGLAS COUNTY SURVEYOR

Station: NU 15 T 26 S, R 5 W , Sec 14  
Set By (Agency): DCSO  
Date Set: 1972  
Recovered By RWS, SJF  
Date Recovered 8/9/85  
Recovered By SJF  
Date Recovered 8-19-91  
Recovered By \_\_\_\_\_  
Date Recovered \_\_\_\_\_

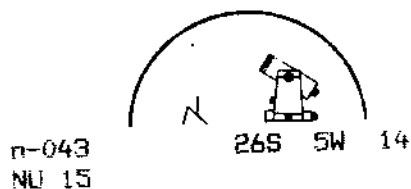

NAD 610479.75 4188215.43  
83 43°18'31" 123°15'17"

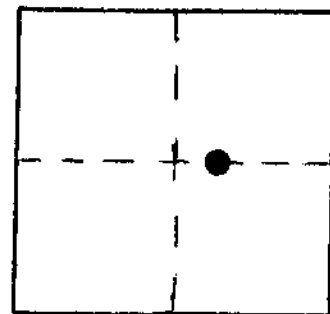

VERTICAL CONTROL NGVD 29

Elevation: 633.116 NGS Line # \_\_\_\_\_ USGS Line # \_\_\_\_\_ OSHD Line # \_\_\_\_\_  
Precision: 2nd Agency: DCSO Proj. # 2006 Date: 1972

HORIZONTAL CONTROL DCS 27

South Zone State Plane Coordinates: Y(Northing) 610,514.93 X(Easting) 1,267,256.35  
Precision: 1/25,000 Agency: DCSO Proj. # 2006 Date: 1972  
Approximate Geographic Position: Latitude 43°18'32" Longitude 123°15'13"

DESCRIPTION and TO REACH


SKETCH

A DCSO disk stamped "NU 15 1972" set in concrete filled 8 in. diam. concrete belltile protruding 4 in. above ground.

TO REACH:

From the intersection of State Highway 99 and North Bank Rd. (Co.Rd.#200) in T26S,R5W,Sec.18 proceed easterly along North Bank Rd. approx. 6.3 miles to a private drive and monument on left.

From the intersection of Echo Bend Dr. (Co.Rd.#363) and North Bank Rd. (Co.Rd.#200) in T25S, R6W, sec. 23, Proceed northerly along North Bank Rd. approx. P.P. 1.2 mi. to mon. on right at M.P. 6.1.

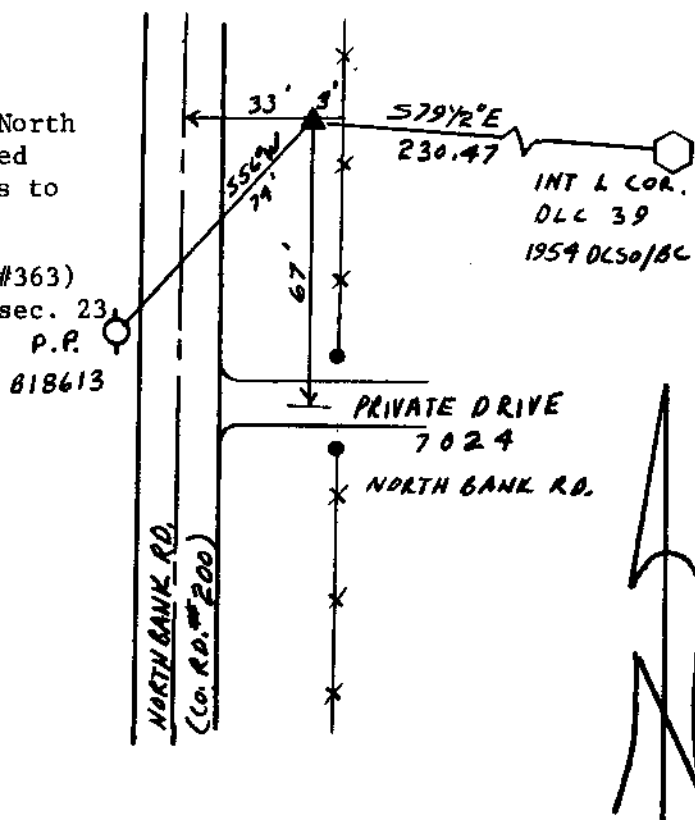

Reference Marks:

Note: For further information, contact the Douglas County Surveyor's Office, Room 205 Douglas County Justice Building, Roseburg, OR 97470. Phone 440-4278. Douglas County residents outside the Roseburg calling area, dial toll free 1-800-452-0991.