

5/7/81

OFFICE OF THE

n-033
NU 5


26S 6W 23

DOUGLAS COUNTY SURVEYOR

NAD
83

606104.79
43°17'37"

4155932.27
123°22'31"

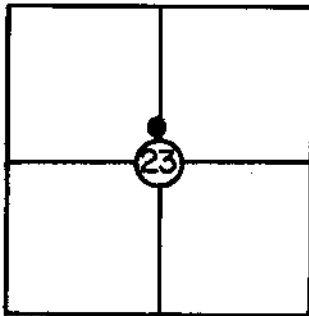

T 26 S, R 6W, Sec. 23

Station: NU 5 (DISTURBED)

Set By (Agency): DCSO

Date: 1972

VERTICAL CONTROL

Elevation: _____ NGS(USC&GS) Line # _____ USGS Line # _____

Order _____
Of Precision _____ Agency: _____ Proj. #: _____ Date: _____

HORIZONTAL CONTROL

OCS 27

Oregon State Plane Coordinates: Y(Northing) 606,139.81 X(Easting) 1,234,973.40
(South Zone)

Order _____ (River Floodplain)
Of Precision 1/25,000 Agency: DCSO Proj. #: 2006 Date: 1974

Approximate Geographic Position: Latitude= 43°17'38" Longitude= 123°22'27"

DESCRIPTION: Brass Cap set in concrete bell tile

on W. side of rd., survey marker

alongside. From junction of Garden Valley

and Fisher Rd. go E. on Fisher Rd. 2.9 mi.,

turn rt. go 0.1 mi. up hill to station.


NOTE *** MONUMENT HAS BEEN DISTURBED

COORDINATES ARE GOOD ONLY FOR APPROXIMATE

LOCATION.

VICINITY: Fisher Rd.

DISTURBED
SKETCH

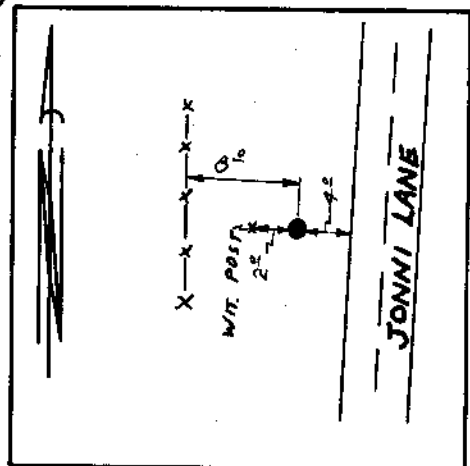

NOTE: For Possible Further Information On This Station, Please Contact The Douglas County Surveyors Office, Rm. 205 Douglas County Justice Bldg., Roseburg, OR. 97470 Phone 672-3311 Ext. 272. Douglas County residents outside the Roseburg calling area dial toll free 1-800-452-0991.