

OFFICE OF THE
DOUGLAS COUNTY SURVEYOR

Station: NU 3 T 26 S, R 6 W, Sec 28

Set By (Agency): DCSO

Date Set: 1972

Recovered By RWS, SJF



Date Recovered 9/25/86

Recovered By _____

Date Recovered _____

Recovered By _____

Date Recovered _____

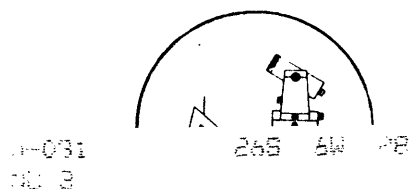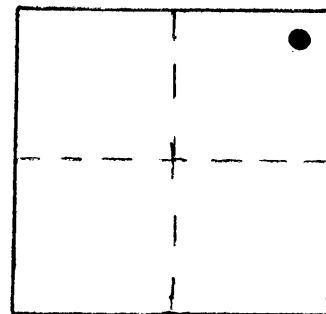

NAD 602747.29 4144495.81
83 43°17' 1" 122°24' 33"

VERTICAL CONTROL NGVD 29

Elevation: * 469.539 NGS Line # _____ USGS Line # _____ OSHD Line # _____

Precision: 2nd Agency: DCSO Proj. # 2007 Date: 1990

HORIZONTAL CONTROL OCS 27

South Zone State Plane Coordinates: Y(Northing) 602,782.33 X(Easting) 1,225,537.07

Precision: 1/25,000 Agency: DCSO Proj. # 2006 & 2013 Date: 1974

Approximate Geographic Position: Latitude 43°17'02" Longitude 123°24'33"

DESCRIPTION and TO REACH


SKETCH

A DCSO disk stamped "NU 3 1972"
set in a boulder flush with ground.

TO REACH:

Go to the intersection
of Garden Valley Rd.
(Co. Rd. #31A) and
Del Rio Rd.
(Co. Rd. #31C) in T26S, R6W,
Sec. 28. Monument lies on
north edge of intersection.

* NOTE: Elevation was corrected in
Feb. 2001; ~~originally~~ typed
incorrectly as 493.427

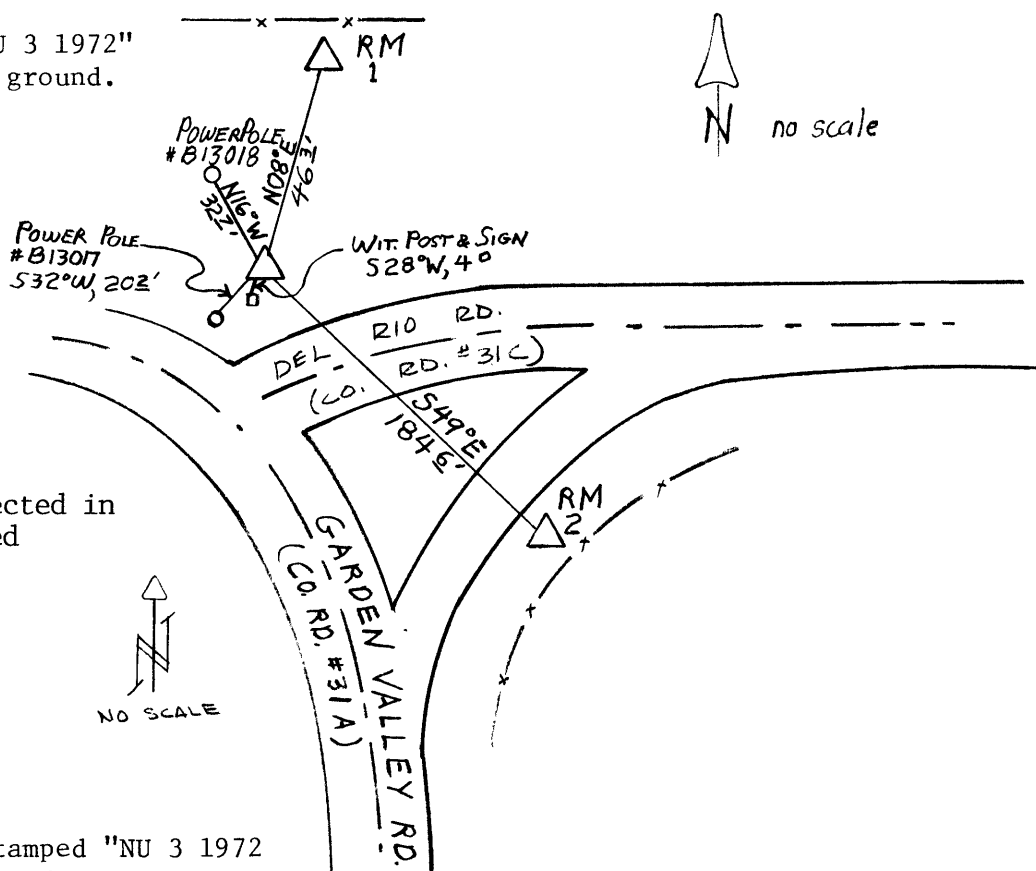

Reference Marks:

A standard DCSO disk stamped "NU 3 1972
RM 1 1979" set in an 8 inch o.d. concrete
filled bell tile set flush with ground, bears
N10°02'13"E, 46.25 ft. distant (grid).

A standard DCSO disk stamped "NU 3 1972 RM 2 1979" set in an 8 inch o.d. concrete
filled bell tile set flush with ground, bears S47°10'12"E, 184.58 ft. distant (grid).

Note: For further information, contact the Douglas County Surveyor's Office, Room 205
Douglas County Justice Building, Roseburg, OR 97470. Phone 440-4278. Douglas
County residents outside the Roseburg calling area, dial toll free 1-800-452-0991.