

OFFICE OF THE
DOUGLAS COUNTY SURVEYOR




k-022
KELLER

26S 6W 36

NAD 595086.60 4161582.44
83 43°15'50" 123°21'10"

Station: KELLER T 26 S, R 6 W , Sec 36
Set By (Agency): DCSO
Date Set: 1983
Recovered By RS, JP
Date Recovered 4/83
Recovered By LEM
Date Recovered 9/20/89
Recovered By _____
Date Recovered _____

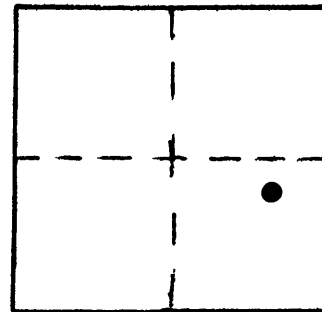

VERTICAL CONTROL *Elevation of original brass cap NGVD 29

Elevation: 536.019 ft NGS Line # _____ USGS Line # _____ OSHD Line # _____
Precision: 2nd Agency: DCSO Proj. # 2007-2013 Date: 1985

HORIZONTAL CONTROL OCS 27

South Zone State Plane Coordinates: Y(Northing) 595,121.65 X(Easting) 1,240,623.77
Precision: 1/5,000 Agency: DCSO Proj. # 2005-2 Date: 1983
Approximate Geographic Position: Latitude 43°15'51" Longitude 123°21'06"

DESCRIPTION and TO REACH


SKETCH

DESCRIPTION:

The stem of a DCSO brass cap remains
in a concrete curb.

TO REACH:

Go to intersection of St. Hwy. 99
and Mary Ann Ln. in T26S, R6W, Sec. 36.

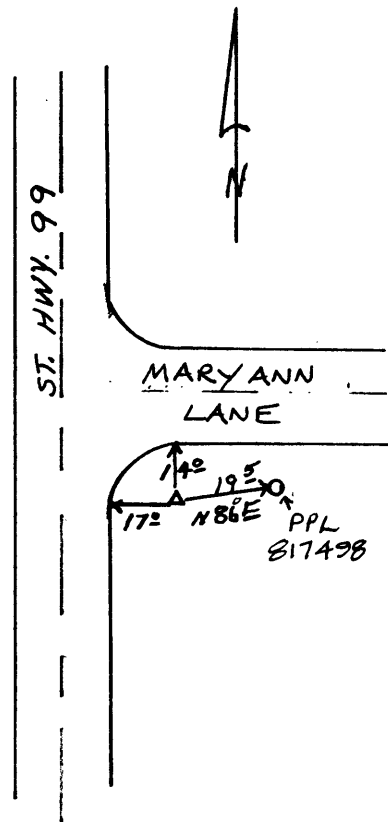

Reference Marks:

Note: For further information, contact the Douglas County Surveyor's Office, Room 205
Douglas County Justice Building, Roseburg, OR 97470. Phone 440-4278. Douglas
County residents outside the Roseburg calling area, dial toll free 1-800-452-0991.