

OFFICE OF THE  
DOUGLAS COUNTY SURVEYOR

Station: MARIAN


T 27 S, R 3W, Sec 11

Date Set: 1999

Set By (Agency): DCSO


Date Recovered: JUNE 30, 1999

Recovered By: RWS, SUF

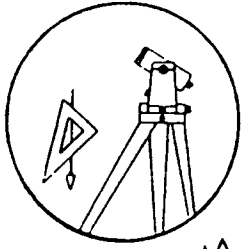

M-111

- Found
- New
- Reset
- Not Found
- Referenced
- Destroyed

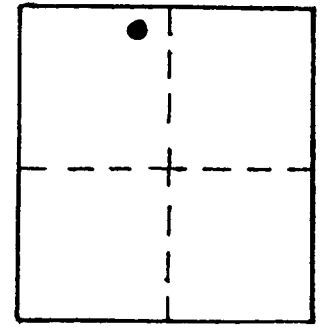

VERTICAL CONTROL

Elevation: 875.30 NGS Line # \_\_\_\_\_ USGS Line # \_\_\_\_\_ OSHD Line # \_\_\_\_\_

Precision: 3rd Agency: DCSO Proj. # 2007 Date: 1999

HORIZONTAL CONTROL CORPSCON6 NAVD88 878.89 FT. CS 66156

South Zone O.C.S. 27: Y(Northing) \_\_\_\_\_ X(Easting) \_\_\_\_\_

South Zone O.C.S. 83: Y(Northing) 584277 X(Easting) 4249438

Precision: GIS SCALED Agency: DCSO Proj. # \_\_\_\_\_ Date: 2014

Approx. ~~NAD 83~~ Geographic Position: Latitude 43°14'32" Longitude 123°01'15"

DESCRIPTION and TO REACH

A 2 1/2 INCH DIAMETER UNMARKED DISK SET DURING BRIDGE CONSTRUCTION STAMPED "DCSO MARIAN 1999" IS SET FLUSH IN TOP SURFACE OF WESTERLY RAILING AND AT NORTHERLY END OF BRIDGE OVER JIM CREEK. MONUMENT IS 2 FEET ABOVE ROAD SURFACE.

GO TO THE INTERSECTION OF CAVITT CREEK RD. (Co. Rd. # 82) AND JIM CREEK ROAD BLM RD. 27-3-11.0 IN T23S, R 3W, SEC 11. MONUMENT IS ON CAVITT CREEK RD. ON BRIDGE OVER JIM CREEK.

Reference Marks:

