

OFFICE OF THE
DOUGLAS COUNTY SURVEYOR



270-04W-20-016

27S 04W 20

SE CORNER

NAD 570052.57 4204882.72
83 43° 11' 57" 123° 11' 14"

Station: SE COR 340300 T 27 S, R 4 W , Sec 20

Set By (Agency): Bentz (RLS #839)

Date Set: 1986

Recovered By RWS, SJF


Date Recovered 10/11/89

Recovered By _____

Date Recovered _____

Recovered By _____

Date Recovered _____

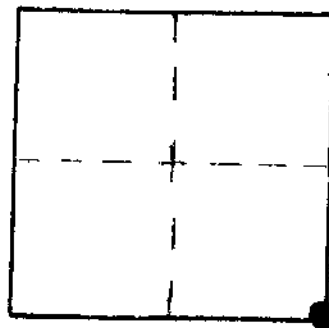

VERTICAL CONTROL

Elevation: _____ NGS Line # _____ USGS Line # _____ OSHD Line # _____

Precision: _____ Agency: _____ Proj. # _____ Date: _____

HORIZONTAL CONTROL NAD 27

South Zone State Plane Coordinates: Y(Northing) 570,088.01 X(Easting) 1,283,924.40

Precision: 1/5,000 Agency: DCSO Proj. # 0002 Date: 1989

Approximate Geographic Position: Latitude 43°11'58" Longitude 123°11'10"

DESCRIPTION and TO REACH

SKETCH

See Douglas County Surveyor's record of government corners renewed.

Reference Marks:

Note: For further information, contact the Douglas County Surveyor's Office, Room 205 Douglas County Justice Building, Roseburg, OR 97470. Phone 440-4278. Douglas County residents outside the Roseburg calling area, dial toll free 1-800-452-0991.