



OFFICE OF THE
DOUGLAS COUNTY SURVEYOR

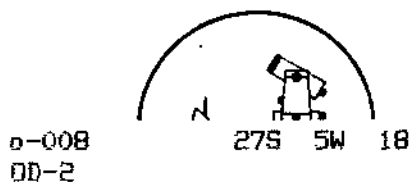

NAD 576880.78 4164719.17
83 43°12'52" 123°20'19"

Station: OD-2 T 27 S, R 5W, Sec 18
Set By (Agency): CITY (RSBG.)
Date Set: ?
Recovered By KR, TP
Date Recovered 5/82
Recovered By _____
Date Recovered _____
Recovered By _____
Date Recovered _____

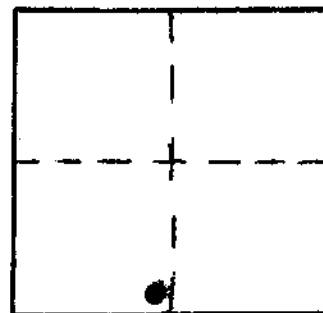

VERTICAL CONTROL

Elevation: _____ NGS Line # _____ USGS Line # _____ OSHD Line # _____
Precision: _____ Agency: _____ Proj. # _____ Date: _____

HORIZONTAL CONTROL NAD 27

South Zone State Plane Coordinates: Y(Northing) 576,915.99 X(Easting) 1,243,760.86
Precision: 1/20,000 Agency: DCSO Proj. # 2005-2 Date: 1983
Approximate Geographic Position: Latitude 43°12'52" Longitude 123°20'15"

DESCRIPTION and TO REACH


SKETCH

DESCRIPTION:

A 0.1 ft.diam. disk stamped "OD-2"
set in concrete curbing.

TO REACH:

Go to the intersection of NE Atlanta St.
and NE Odell Ave.

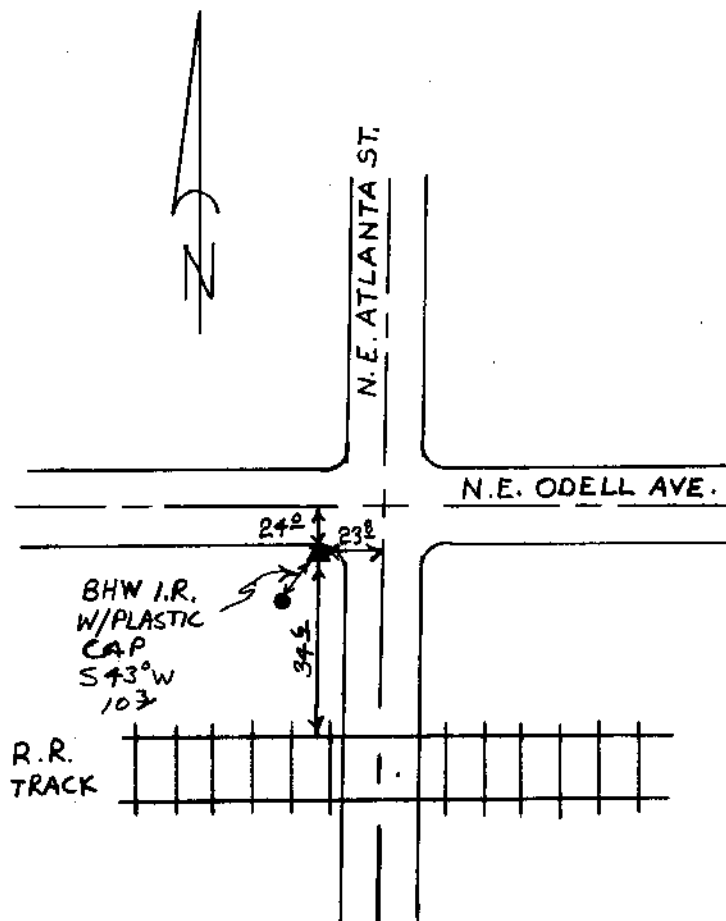

Reference Marks:

Note: For further information, contact the Douglas County Surveyor's Office, Room 205
Douglas County Justice Building, Roseburg, OR 97470. Phone 440-4278. Douglas
County residents outside the Roseburg calling area, dial toll free 1-800-452-0991.