



OFFICE OF THE
DOUGLAS COUNTY SURVEYOR

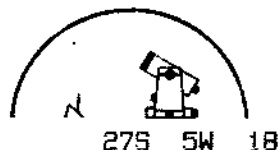

r-055
RPEQ

NAD 579518.30 4162960.37
83 43°13'17" 123°20'44"

Station: RPEQ T 27 S, R 5 W, Sec 18
Set By (Agency): OSHD
Date Set: ?
Recovered By GQ, KR, JP
Date Recovered 6/82
Recovered By DCSO 10/98
Date Recovered _____
Recovered By _____
Date Recovered _____

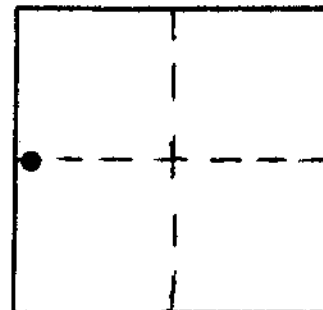

VERTICAL CONTROL NGVD29

Elevation: 551.79 NGS Line # _____ USGS Line # _____ OSHD Line # _____

Precision: 3rd Agency: DCSO Proj. # 2007 Date: 10/98
CS66/46

HORIZONTAL CONTROL NAD27

South Zone State Plane Coordinates: Y(Northing) 579,553.49 X(Easting) 1,242,002.07

Precision: 1/20,000 Agency: DCSO Proj. # 2005-2 Date: 1983

Approximate Geographic Position: Latitude 43°13'18" Longitude 123°20'40"


DESCRIPTION and TO REACH

SKETCH

DESCRIPTION:

A brass cap set flush in a
concrete sidewalk. MARKED
OSHD RP EQ+34.80 RT
TO REACH:

Go to intersection of NE Stephens St.
and NE Imbler Ave.

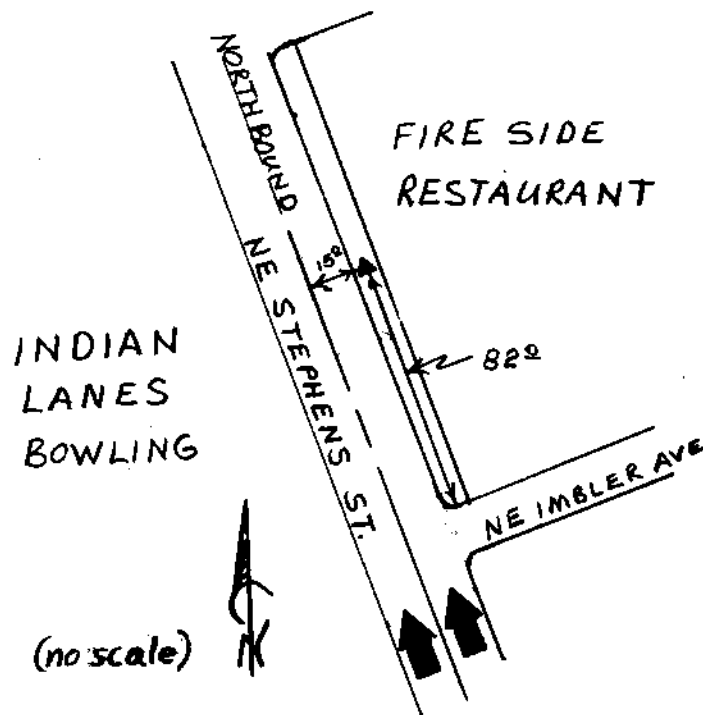

Reference Marks:

Note: For further information, contact the Douglas County Surveyor's Office, Room 205
Douglas County Justice Building, Roseburg, OR 97470. Phone 440-4278. Douglas
County residents outside the Roseburg calling area, dial toll free 1-800-452-0991.