



OFFICE OF THE
DOUGLAS COUNTY SURVEYOR

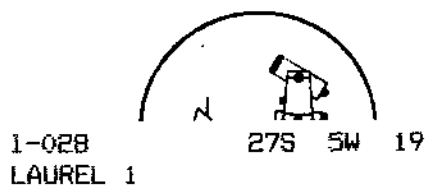

NAD 573306.91 4165080.89
83 43°12'17" 123°20'13"

Station: LAUREL 1 T 27 S, R 5 W, Sec 19
Set By (Agency): CITY (RSBG)
Date Set: ?
Recovered By TP,JP
Date Recovered 8/82
Recovered By _____
Date Recovered _____
Recovered By _____
Date Recovered _____

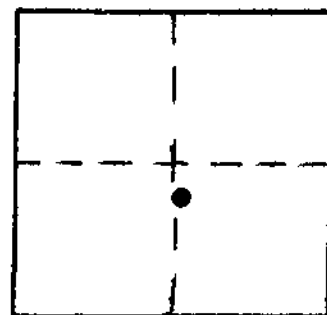

VERTICAL CONTROL

Elevation: _____ NGS Line # _____ USGS Line # _____ OSHD Line # _____
Precision: _____ Agency: _____ Proj. # _____ Date: _____

HORIZONTAL CONTROL O.C.S 27

South Zone State Plane Coordinates: Y(Northing) 573,342.14 X(Easting) 1,244,122.56
Precision: 1/20,000 Agency: DCSO Proj. # 2005-2 Date: 1983
Approximate Geographic Position: Latitude 43°12'17" Longitude 123°20'08"

DESCRIPTION and TO REACH


DESCRIPTION:

A brass cap street monument set
below pavement with access cover above.

TO REACH:

From the intersection of SE Laurel Dr.
and SE Terrace Dr. proceed northerly along
SE Laurel Dr. 0.25 miles to monument
in center of culdesac.

SKETCH

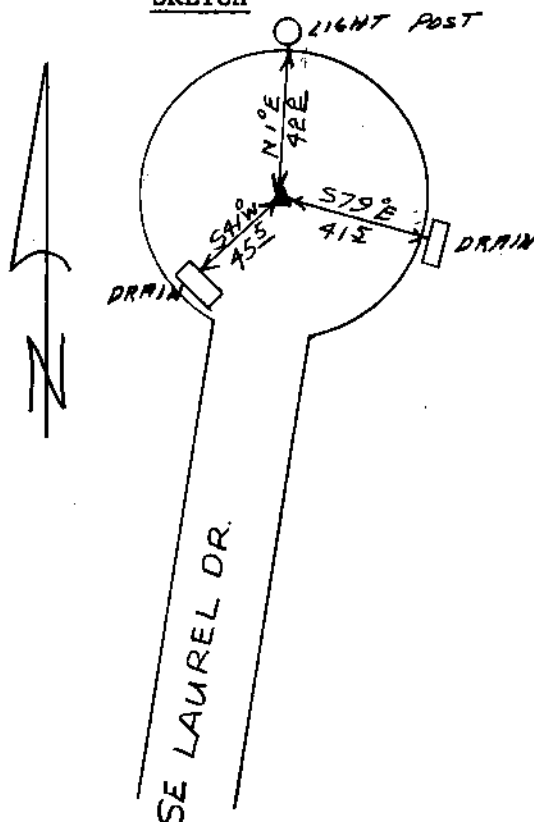

Reference Marks:

Note: For further information, contact the Douglas County Surveyor's Office, Room 205
Douglas County Justice Building, Roseburg, OR 97470. Phone 440-4278. Douglas
County residents outside the Roseburg calling area, dial toll free 1-800-452-0991.