

5/82


OFFICE OF THE

e-003  
E 253 RESET

275 5W 23

DOUGLAS COUNTY SURVEYOR

|     |           |            |
|-----|-----------|------------|
| NAD | 575128.95 | 4185070.98 |
| 83  | 43°12'41" | 123°15'44" |

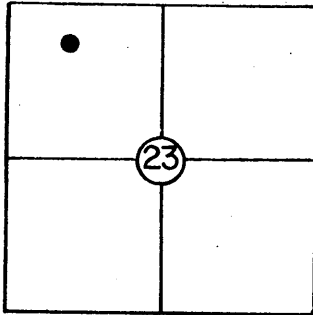

T 27 S, R 5W, Sec. 23

Station: E 253 Reset

Set By (Agency): OSHD

Date: 1952

FD 6/02 DCSO, FD 1/03 DCSO

VERTICAL CONTROL NGVD 29

Elevation: 542.674<sup>?</sup> NGS(USC&GS) Line # 94 USGS Line #Order  
Of Precision 1st<sup>?</sup> Agency: USC&GS Proj. #: Date: 1961

HORIZONTAL CONTROL OCS 27

Oregon State Plane Coordinates: Y(Northing) 575,164.33<sup>?</sup> X(Easting) 1,264,112.56<sup>?</sup>  
(South Zone)Order  
Of Precision 1/50,000<sup>?</sup> Agency: DCSO Proj. #: 6012-7 Date: 1977


Approximate Geographic Position: Latitude= 43° 12' 42" Longitude= 123° 15' 39"

**\* JUNE 2002 REPORT****FOUND 1/2 OF CAP WITH STEM IN CONC. MON.  
HAS CENTER + ON REMAINING BC.**

A USC&GS bronze disk stamped "E 253 Reset 1952", set in a 12" square concrete monument projecting 4" above ground, 1.0 ft. N of a survey marker witness post 27.7 ft. N50°E of power pole #B 15897, 27.5 ft. S30°W of the centerline of the old road to Dixonville (Co. Rd. #4B.1) approx. 140 ft. w'stly of the intersection of the N. Umpqua Hwy. and Buckhorn Rd. (Co. Rd. #4B.1)

VICINITY: Approx. 4 mi. e'stly of Roseburg along the old road to Dixonville.

SKETCH

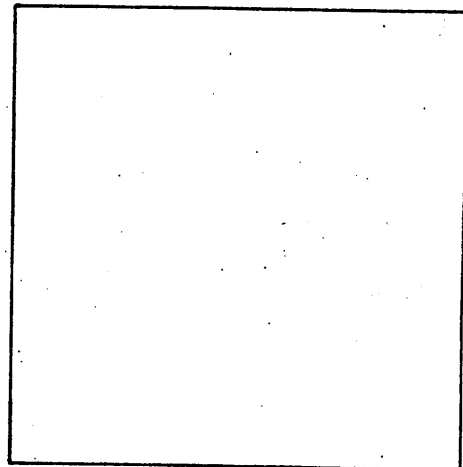

NOTE: For Possible Further Information On This Station, Please Contact The Douglas County Surveyors Office, Rm. 205 Douglas County Justice Bldg., Roseburg, OR. 97470 Phone 672-3311 Ext. 272. Douglas County residents outside the Roseburg calling area dial toll free 1-800-452-0991.