

OFFICE OF THE
DOUGLAS COUNTY SURVEYOR

Station: Roseburg CBL 1440

T 27 S, R 6W , Sec 1

Date Set: 1989

Set By (Agency): N.G.S.

Date Recovered: 6-27-91


Recovered By: RWS

Date Recovered: _____

Recovered By: _____


Date Recovered: _____

Recovered By: _____

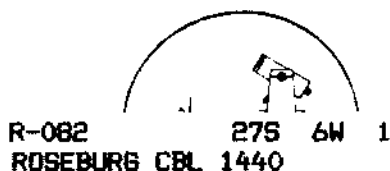

R-082 275 6W 1
ROSEBURG CBL 1440

NAD 588392.98 4160683.68
83 43°14'44" 123°21'19"

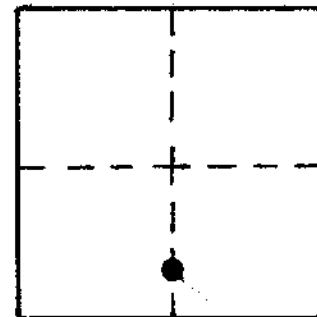

VERTICAL CONTROL NGVD 29

Elevation: 535.73 NGS Line # _____ USGS Line # _____ OSHD Line # _____

Precision: 3rd Order Agency: NGS Proj. # 83/91 GPS NETWORK Date: 1991

HORIZONTAL CONTROL

South Zone O.C.S. 27: Y(Northing) 588,428.14 X(Easting) 1,239,725.38

South Zone O.C.S. 83: Y(Northing) _____ X(Easting) _____

Precision: 1/25,000 Agency: DCSO Proj. # GPS 27/83 Date: 1991


Approx. NAD 83 Geographic Position: Latitude _____ Longitude _____

DESCRIPTION and TO REACH

Found: A N.G.S. brass cap set in a 1 ft. x 1 ft. concrete post flush with the ground.

To Reach: At the northeast end of Roseburg airport runway, monument is 200 ft. northeast.

SKETCH

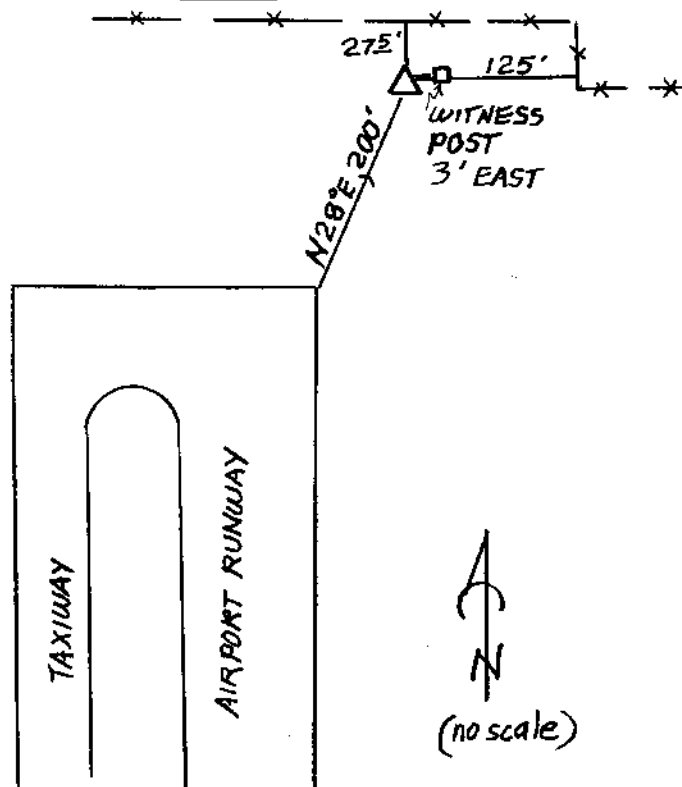

Reference Marks:

Note: For further information, contact the Douglas County Surveyor's Office, Room 205 Douglas County Justice Building, Roseburg, OR 97470. Phone 440-4278. Douglas County residents outside the Roseburg calling area, dial toll free 1-800-452-0991.