
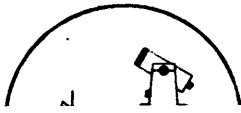


OFFICE OF THE
DOUGLAS COUNTY SURVEYOR

Station: GQ T 27 S, R 6 W , Sec 11
 Set By (Agency): DCSO
 Date Set: 1982
 Recovered By JP, TP
 Date Recovered 7/82
 Recovered By RWS-SJF
 Date Recovered 2000
 Recovered By OK SJF-JP 1/2008
 Date Recovered _____

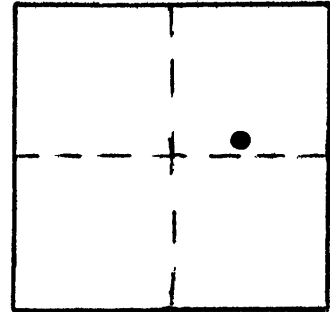

g-035
GQ

27S 6W 11

NAD 584525.20 4154922.87
83 43°14' 4" 123°22' 35"

VERTICAL CONTROL NGVD 29

Elevation: 480.019 NGS Line # _____ USGS Line # _____ OSHD Line # _____
 Precision: 2nd Agency: DCSO Proj. # 2007 Date: 1990

HORIZONTAL CONTROL OCS 27

South Zone State Plane Coordinates: Y(Northing) 584,560.32 X(Easting) 1,233,964.54
 Precision: 1/20,000 Agency: DCSO Proj. # 2005-2 Date: 1983
 Approximate Geographic Position: Latitude 43°14' 04.6" Longitude 123°22' 30.6"

DESCRIPTION and TO REACH


SKETCH

DESCRIPTION:

A DCSO disk stamped "GQ 1982"
set flush in concrete curbing.

TO REACH:

From the intersection of Garden Valley Blvd.
and Stewart Parkway, proceed westerly along
Garden Valley Blvd. 0.2 miles to the most
westerly entrance of Roseburg Valley Mall and
station.

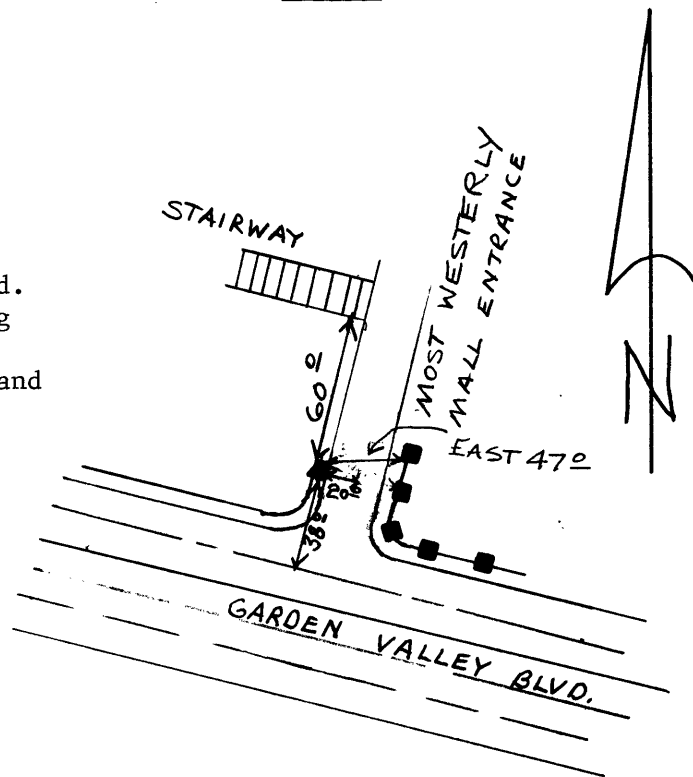

Reference Marks:

Note: For further information, contact the Douglas County Surveyor's Office, Room 205
Douglas County Justice Building, Roseburg, OR 97470. Phone 440-4278. Douglas
County residents outside the Roseburg calling area, dial toll free 1-800-452-0991.