

OFFICE OF THE
DOUGLAS COUNTY SURVEYOR




#-068
19-3

27S 6W 14

NAD 577203.14 4154247.66
83 43°12'51" 123°22'41"

Station: 19-3. T 27 S, R 6 W , Sec 14
Set By (Agency): CITY(RSBG)
Date Set: ?
Recovered By KR,TP
Date Recovered 5/82
Recovered By _____
Date Recovered _____
Recovered By _____
Date Recovered _____

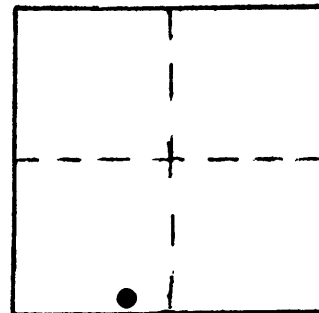

VERTICAL CONTROL

Elevation: _____ NGS Line # _____ USGS Line # _____ OSHD Line # _____
Precision: _____ Agency: _____ Proj. # _____ Date: _____

HORIZONTAL CONTROL OCS 27

South Zone State Plane Coordinates: Y(Northing) 577,238.27 X(Easting) 1,233,289.29
Precision: 1/20,000 Agency: DCSO Proj. # 2005-2 Date: 1983
Approximate Geographic Position: Latitude 43°12'52" Longitude 123°22'36"

DESCRIPTION and TO REACH


SKETCH

DESCRIPTION:

A 0.1 ft. diam. disk stamped "19-3"
set flush in concrete curbing.

TO REACH:

Go to intersection of W. Pilger St.
and W. Harvard Blvd.

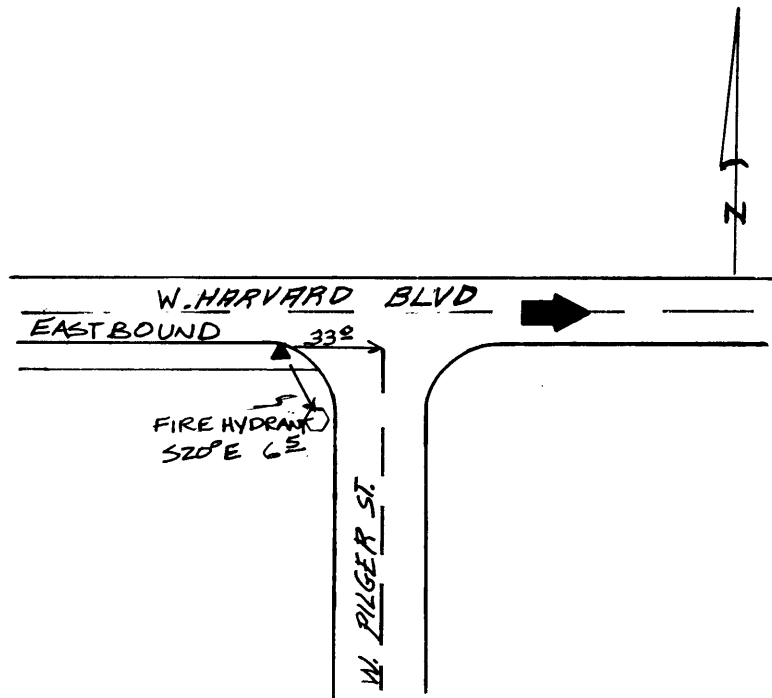

Reference Marks:

Note: For further information, contact the Douglas County Surveyor's Office, Room 205
Douglas County Justice Building, Roseburg, OR 97470. Phone 440-4278. Douglas
County residents outside the Roseburg calling area, dial toll free 1-800-452-0991.