


OFFICE OF THE
DOUGLAS COUNTY SURVEYOR

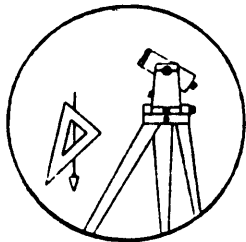


N-073

Station: NEWT
Date Set: ?
Set By (Agency): RSBG
Date Recovered: 5-24-00
Recovered By: KWS SJF

☒ Found ☐ New
☐ Reset ☐ Not Found
☐ Referenced ☐ Destroyed

T 27 S, R 6W, Sec 14

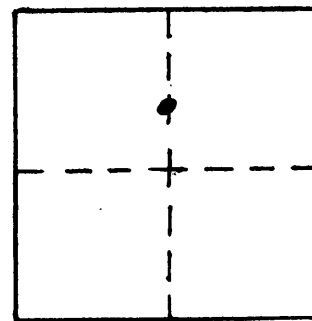

VERTICAL CONTROL NGVD 29

Elevation: 433.79 NGS Line # _____ USGS Line # _____ OSHD Line # _____
Precision: 3rd Agency: DCSO Proj. # 66/38 Date: 2000

HORIZONTAL CONTROL

South Zone O.C.S. 27: Y(Northing) _____ X(Easting) _____
South Zone O.C.S. 83: Y(Northing) _____ X(Easting) _____

Precision: _____ Agency: _____ Proj. # _____ Date: _____

Approx. NAD 83 Geographic Position: Latitude 43° 13' 30.4" Longitude 123° 22' 35.8"
27 43° 13' 31.0" 123° 22' 31.5"

DESCRIPTION and TO REACH

ROSEBURG BRASS W/L STAMP "NEWT 2000"
SET IN CONCRETE AT SOUTHEAST CORNER OF
BRIDGE OVER NEWTON CREEK

GO TO BRIDGE OVER NEWTON CREEK ON KEASY ROAD
IN ROSEBURG

Reference Marks:

