

OFFICE OF THE
DOUGLAS COUNTY SURVEYOR




#-092
40-6

27S 6W 24

NAD 574978.15 4161592.60
83 43°12'32" 123°21' 1"

Station: 40-6
Set By (Agency): CITY(RSBG)
Date Set: ?
Recovered By LEM, TRP
Date Recovered 9/81
Recovered By _____
Date Recovered _____
Recovered By _____
Date Recovered _____

T 27 S, R 6 W, Sec 24

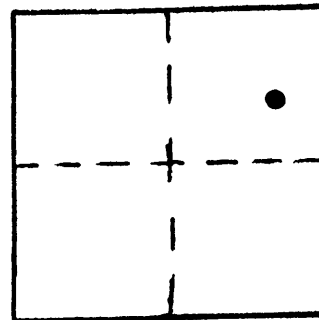

VERTICAL CONTROL

Elevation: _____ NGS Line # _____ USGS Line # _____ OSHD Line # _____
Precision: _____ Agency: _____ Proj. # _____ Date: _____

HORIZONTAL CONTROL OCS 27

South Zone State Plane Coordinates: Y(Northing) 575,013.35 X(Easting) 1,240,634.27
Precision: 1/20,000 Agency: DCSO Proj. # 2005-2 Date: 1983
Approximate Geographic Position: Latitude 43°12'33" Longitude 123°20'56"

DESCRIPTION and TO REACH


SKETCH

DESCRIPTION:

A 1 1/4 in. diam. disk stamped "40-6"
set flush in concrete sidewalk.

TO REACH:

Go to intersection of SE Lane Ave.
and SE Parrott St.

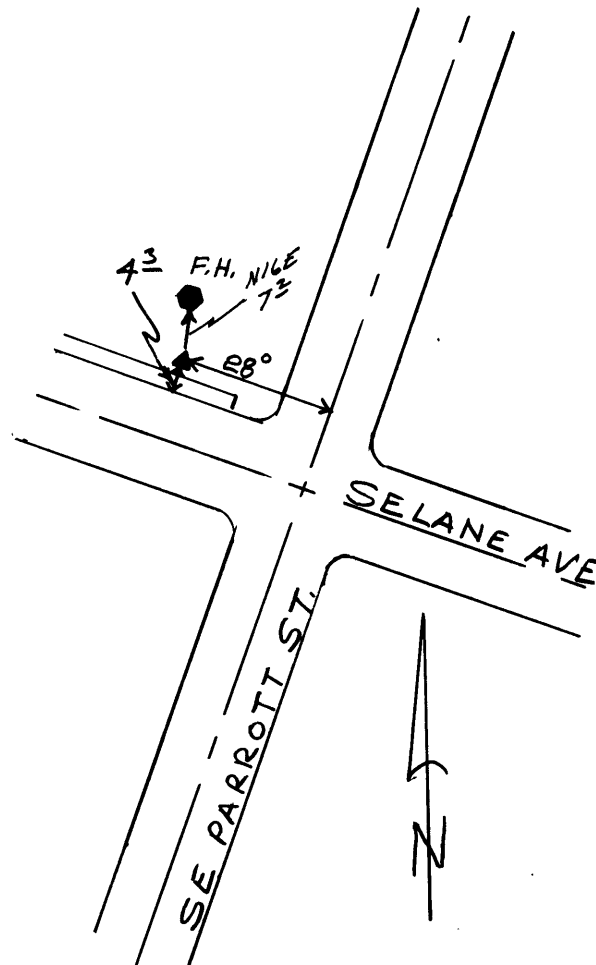

Reference Marks:

Note: For further information, contact the Douglas County Surveyor's Office, Room 205
Douglas County Justice Building, Roseburg, OR 97470. Phone 440-4278. Douglas
County residents outside the Roseburg calling area, dial toll free 1-800-452-0991.