

OFFICE OF THE
DOUGLAS COUNTY SURVEYOR

Station: MADWOOD T 27 S, R 6 W , Sec 24

Set By (Agency): CITY(RSBG)

Date Set: ?

Recovered By KR



Date Recovered 5/82

Recovered By _____

Date Recovered _____

Recovered By _____

Date Recovered _____

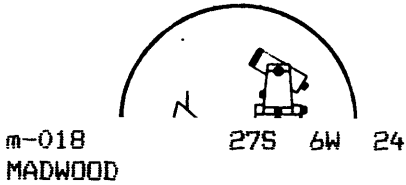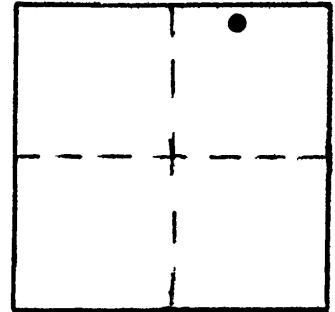

NAD 576843.70 4161280.08
83 43°12'50" 123°21' 6"

VERTICAL CONTROL

Elevation: _____ NGS Line # _____ USGS Line # _____ OSHD Line # _____

Precision: _____ Agency: _____ Proj. # _____ Date: _____

HORIZONTAL CONTROL *OCS 27*

South Zone State Plane Coordinates: Y(Northing) 576,878.89 X(Easting) 1,240.321.76

Precision: 1/20,000 Agency: DCSO Proj. # 2005-2 Date: 1983

Approximate Geographic Position: Latitude 43°12'51" Longitude 123°21'01"

DESCRIPTION and TO REACH


SKETCH

DESCRIPTION:

A brass cap street monument set below pavement with access cover above.

TO REACH:

Go to intersection of W. Madrone St.
and W. Laurelwood Ct.

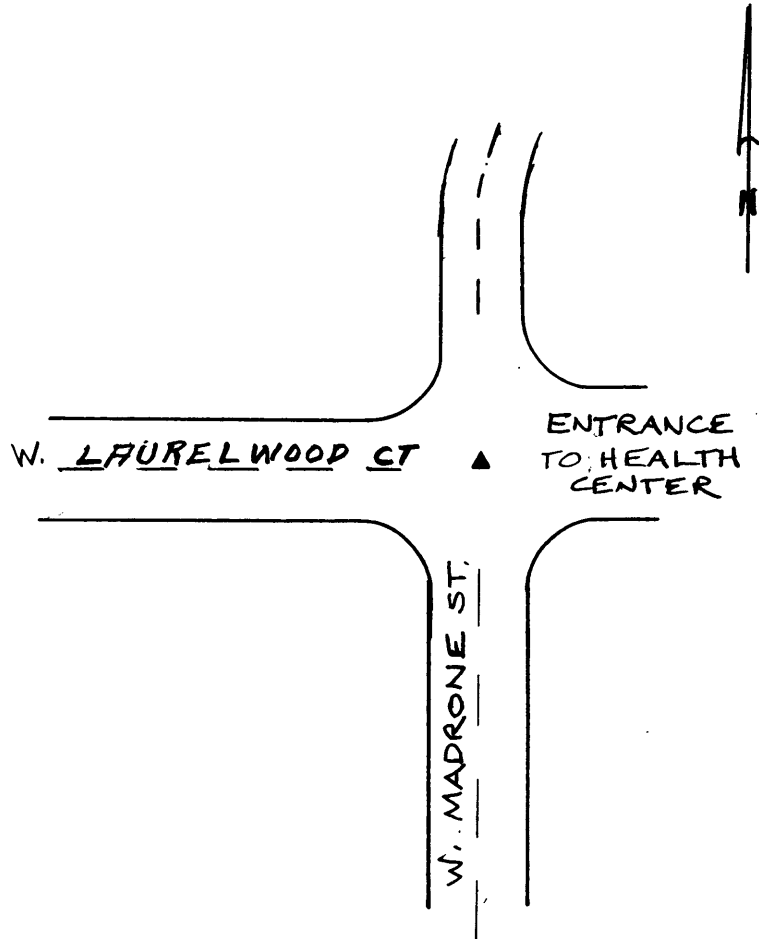

Reference Marks:

Note: For further information, contact the Douglas County Surveyor's Office, Room 205 Douglas County Justice Building, Roseburg, OR 97470. Phone 440-4278. Douglas County residents outside the Roseburg calling area, dial toll free 1-800-452-0991.