

OFFICE OF THE
DOUGLAS COUNTY SURVEYOR

Station: STEPWA T 27 S, R 6 W, Sec 24

Set By (Agency): CITY (RSBG.)

Date Set: ?

Recovered By KR, TP


Date Recovered 5/82

Recovered By _____

Date Recovered _____

Recovered By _____

Date Recovered _____

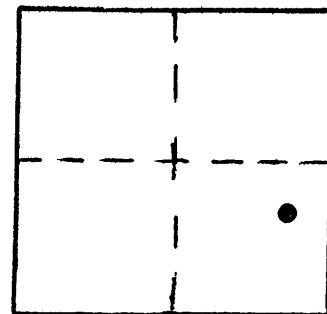

s-136
STEPWA 27S 6W 24

NAD 572777.84 4161344.21
83 43°12'10" 123°21' 3"

VERTICAL CONTROL

Elevation: _____ NGS Line # _____ USGS Line # _____ OSHD Line # _____

Precision: _____ Agency: _____ Proj. # _____ Date: _____

HORIZONTAL CONTROL OCS 27

South Zone State Plane Coordinates: Y(Northing) 572,813.04 X(Easting) 1,240,385.86

Precision: 1/20,000 Agency: DCSO Proj. # 2005-2 Date: 1983

Approximate Geographic Position: Latitude 43°12'11" Longitude 123°20'59"

DESCRIPTION and TO REACH


SKETCH

DESCRIPTION:

A 1 in. diam. bolt street monument
set below pavement with access cover
above.

TO REACH:

Go to intersection of SE Waite Ave.
and SE Stephens St.

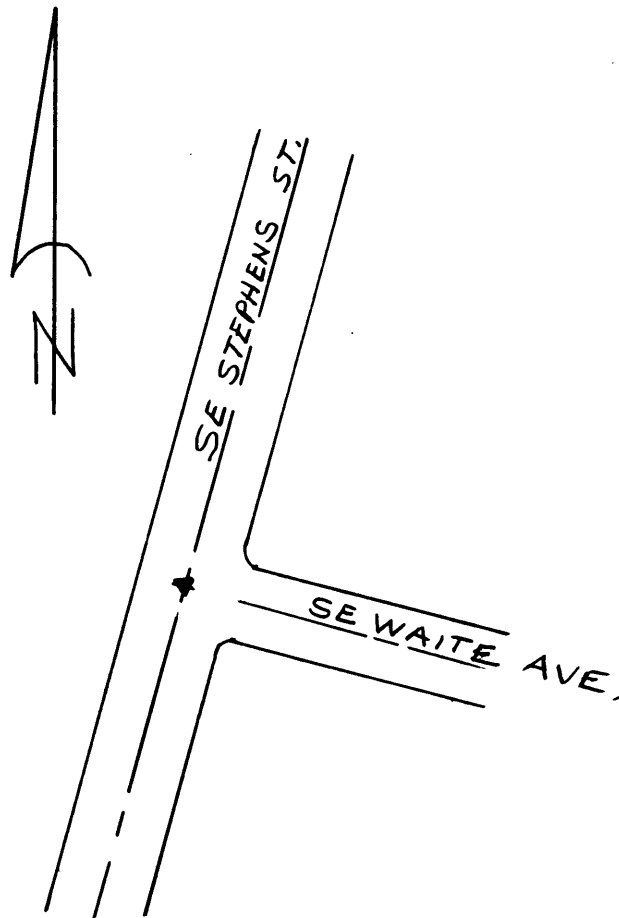

Reference Marks:

Note: For further information, contact the Douglas County Surveyor's Office, Room 205
Douglas County Justice Building, Roseburg, OR 97470. Phone 440-4278. Douglas
County residents outside the Roseburg calling area, dial toll free 1-800-452-0991.