

OFFICE OF THE
DOUGLAS COUNTY SURVEYOR

Station: WOODMILL T 27 S, R 6W, Sec 24

Set By (Agency): CITY (RSBG)

Date Set: ?

Recovered By KR



Date Recovered 5/82

Recovered By

Date Recovered

Recovered By

Date Recovered

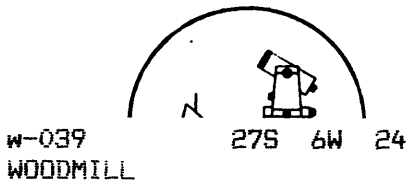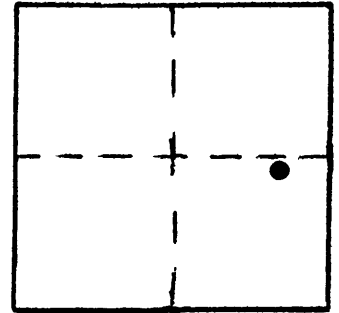

NAD 574143.77 4161469.34
83 43°12'24" 123°21' 2"

VERTICAL CONTROL

Elevation: NGS Line # USGS Line # OSHD Line #

Precision: Agency: Proj. # Date:

HORIZONTAL CONTROL OCS 27

South Zone State Plane Coordinates: Y(Northing) 574,178.97 X(Easting) 1,240,511.00

Precision: 1/20,000 Agency: DCSO Proj. # 2005-2 Date: 1983

Approximate Geographic Position: Latitude 43°12'24" Longitude 123°20'58"

DESCRIPTION and TO REACH


SKETCH

DESCRIPTION:

A 1 in. I.P. and tack street monument
set below pavement with access cover
above.

TO REACH:

Go to intersection of SE Mill St. and
SE Woodward Ave.

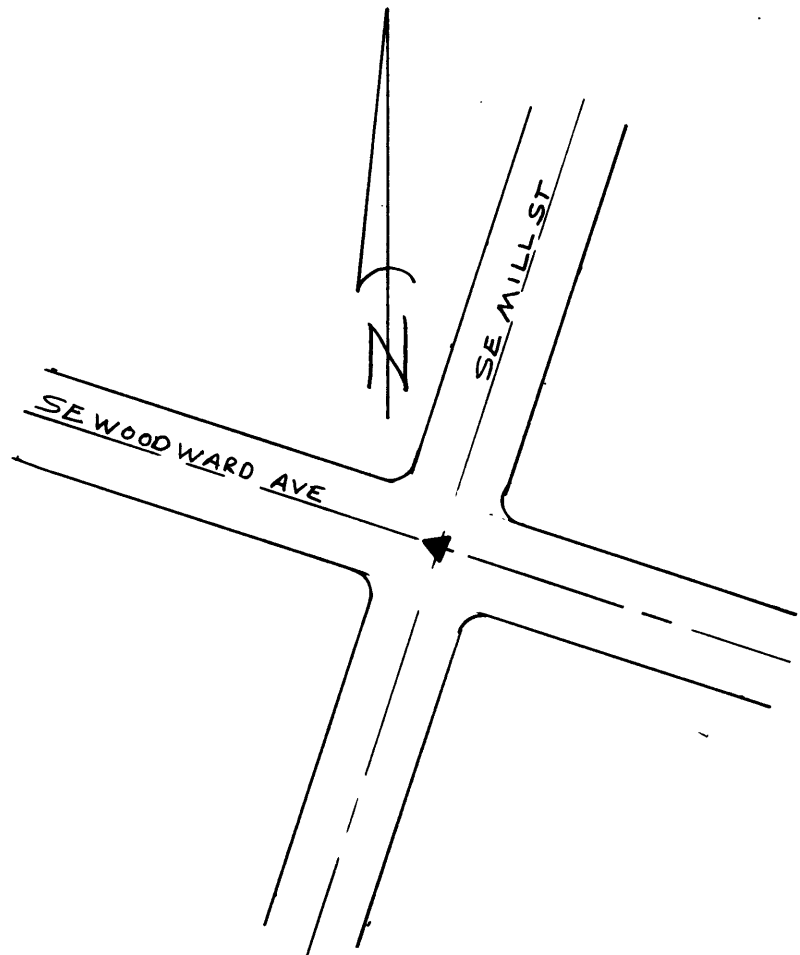

Reference Marks:

Note: For further information, contact the Douglas County Surveyor's Office, Room 205
Douglas County Justice Building, Roseburg, OR 97470. Phone 440-4278. Douglas
County residents outside the Roseburg calling area, dial toll free 1-800-452-0991.