

OFFICE OF THE  
DOUGLAS COUNTY SURVEYOR

Station: HILLERY T 27 S, R 6W , Sec 25

Set By (Agency): DCSO

Date Set: 1982

Recovered By TP, KR


Date Recovered 1982

Recovered By \_\_\_\_\_

Date Recovered \_\_\_\_\_

Recovered By \_\_\_\_\_

Date Recovered \_\_\_\_\_

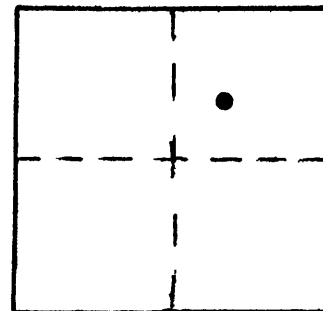

h-041 275 6W 25  
HILLERY

NAD 570500.64 4160582.14  
83 43°11'47" 123°21'12"

VERTICAL CONTROL

Elevation: \_\_\_\_\_ NGS Line # \_\_\_\_\_ USGS Line # \_\_\_\_\_ OSHD Line # \_\_\_\_\_

Precision: \_\_\_\_\_ Agency: \_\_\_\_\_ Proj. # \_\_\_\_\_ Date: \_\_\_\_\_

HORIZONTAL CONTROL **OCS 27**

South Zone State Plane Coordinates: Y(Northing) 570,535.84 X(Easting) 1,239,623.78

Precision: 1/20,000 Agency: DCSO Proj. # 2005-2 Date: 1983

Approximate Geographic Position: Latitude 43°11'48" Longitude 123°21'08"

DESCRIPTION and TO REACH


SKETCH

DESCRIPTION:

A DCSO disk stamped "HILLERY 1982"  
set 0.2 ft. below rock surface.

TO REACH:

At the intersection of Southgate shopping  
center and old Hwy. 99 in Roseburg. Proceed  
to monument on rock outcrop on the west side  
of road, under billboard.

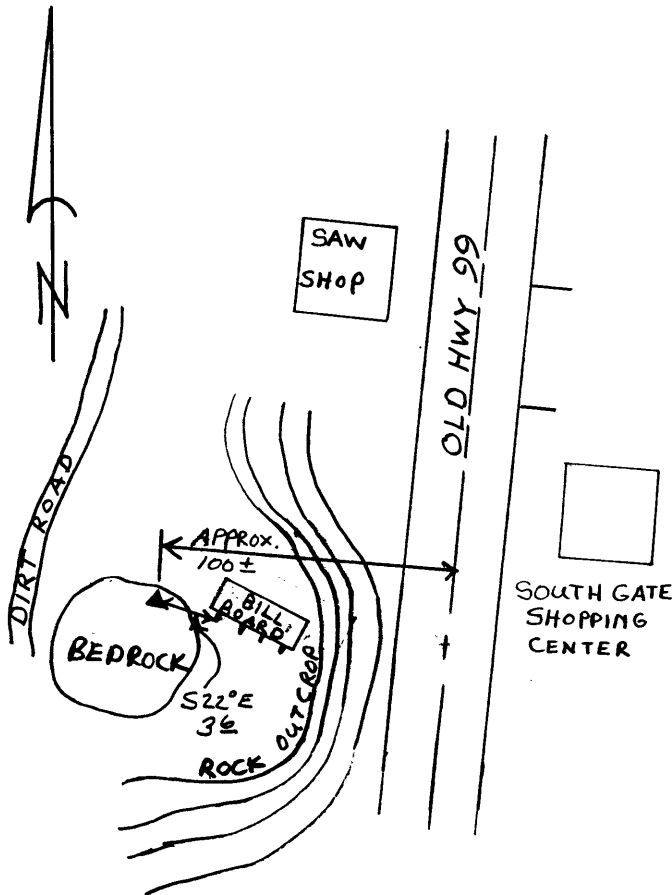

Reference Marks:

Note: For further information, contact the Douglas County Surveyor's Office, Room 205 Douglas County Justice Building, Roseburg, OR 97470. Phone 440-4278. Douglas County residents outside the Roseburg calling area, dial toll free 1-800-452-0991.