


OFFICE OF THE
DOUGLAS COUNTY SURVEYOR

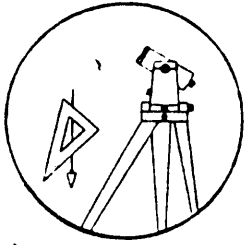

W-067

DESTROYED

Station: WES

T 27 S, R 6W, Sec 35


Date Set: 3-26-98

Set By (Agency): DCSO

Date Recovered: 3-26-98; 5/8/02 ^{FD OK}

Recovered By: WES SJF

- Found
- New
- Reset
- Not Found
- Referenced
- Destroyed

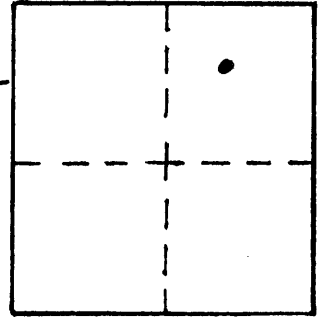

VERTICAL CONTROL NGVD 29

Elevation: 458.72 NGS Line # _____ USGS Line # _____ OSHD Line # _____

Precision: 3rd Agency: DCSO Proj. # CS 66142 2007 Date: 4/5/99

HORIZONTAL CONTROL

South Zone O.C.S. 27: Y(Northing) _____ X(Easting) _____

South Zone O.C.S. 83: Y(Northing) _____ X(Easting) _____

Precision: _____ Agency: _____ Proj. # _____ Date: _____

Approx. ~~NAD 83~~ Geographic Position: Latitude 43° 11' 00" Longitude 123° 22' 20"

DESCRIPTION and TO REACH

DCSO DRILL CHIP SET IN ROCK OUT CROP

GO TO THE INTERSECTION OF MCCLAIN AVE
AND I-5 (EXIT 121) STATION IS
ON EAST SIDE OF INTERSECTION
APPROX 25' EAST OF
FRONTAGE ROAD CENTERLINE

* ROAD SHOULDER WORK
REMOVED MONUMENT.

MONUMENT DESTROYED
PER DCSO APR. 20, 2009

Reference Marks:

