

OFFICE OF THE
DOUGLAS COUNTY SURVEYOR

Station: P247, RM 1 T 28 S, R 6 W , Sec 15

Set By (Agency): D.C.S.O.

Date Set: 1978

Recovered By RS, SJF



Date Recovered June 21, 1984

Recovered By _____

Date Recovered _____

Recovered By _____

Date Recovered _____

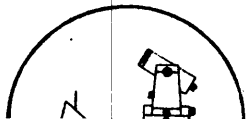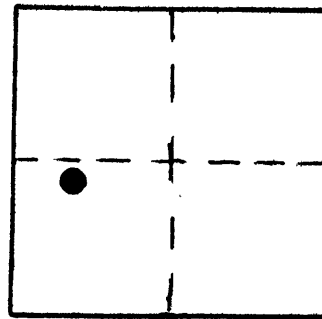

p-006
P 247 RM 1

28S 6W 15

NAD 547864.61 4147412.49
83 43° 7'59" 123°23'59"

VERTICAL CONTROL

Elevation: 504.50 NGS Line # _____ USGS Line # _____ OSHD Line # _____

Precision: 3RD Agency: DCSO Proj. # CS 67/17 Date: 2005

HORIZONTAL CONTROL

South Zone State Plane Coordinates: Y(Northing) 547,899.77 X(Easting) 1,226,454.17

Precision: 1/25,000 Agency: D.C.S.O. Proj. # 2004-15 C.S.60/16 Date: 1978


Approximate Geographic Position: Latitude 43°08'00" Longitude 123°23'55"

DESCRIPTION and TO REACH

A D.C.S.O. disk stamped "P247 RM 1 1978" set flush in the southwest corner of the State Highway 99 southerly bridge over the South Umpqua River.

TO REACH:

Go to the State Highway 99 southerly bridge over the South Umpqua River (the bridge for the northeast bound lanes) in T28S, R6W, Sec. 15.

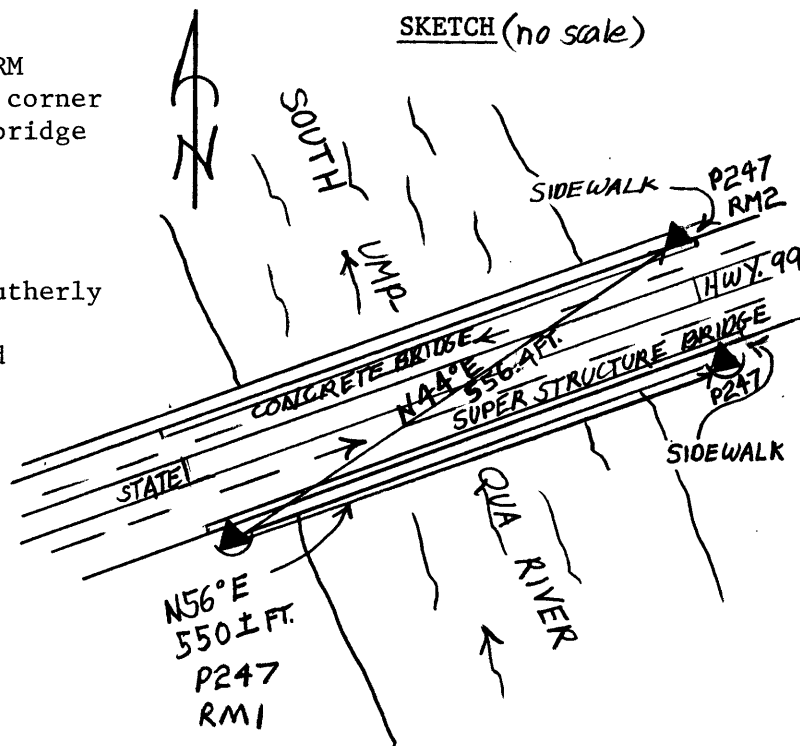

Reference Marks:

A D.C.S.O. disk stamped "P247 RM 2 1978" bears N46°18'15"E 556.40 feet (grid).

Note: For further information, contact the Douglas County Surveyor's Office, Room 205 Douglas County Justice Building, Roseburg, OR 97470. Phone 440-4278. Douglas County residents outside the Roseburg calling area, dial toll free 1-800-452-0991.