


# Douglas County Geodetic Data Sheet

Station: DILL-2  
 Date Set: 1998 Set By (Agency): DCSO  
 Last Date Recovered: 01/00/2001

Designation: D-087

T 28 R 06 WS 33 C

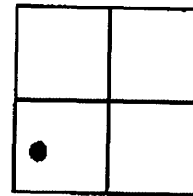

## VERTICAL CONTROL

NGVD 29 Elevation: 605.80 Feet  
 Precision: 3RD ORDER Agency: DCSO  
 NAVD 88 Elevation: 609.26 FEET  
 Precision: CORPSON 6 Agency: ~~Meters~~

CS File: 66055

Date: 1998

CS File:

Date:

## HORIZONTAL CONTROL

OCS 27	Y(Northing):	X(Easting):	Lat 43° 05' 13.8"	Long: 123° 25' 16.2"
Precision:	GIS	Agency:	CS File:	Date:
OCS 83	Y(Northing):	X(Easting):	Lat	Long:
Precision:		Agency:	CS File:	Date:
OCS 83/91	Y(Northing):	X(Easting):	Lat	Long:
Precision:		Agency:	CS File:	Date:
OCS 83/98	Y(Northing):	X(Easting):	Lat	Long:
Precision:		Agency:	CS File:	Date:


### Description:

Scaled Lat 43° 05' 14" Long: 123° 25' 16"

A DCSO DRILL CAP STAMPED; DILL-2 1998; SET FLUSH IN TOP OF AN 8 X 42 INCH CONCRETE FILLED CONCRETE BELL TILE; PROTRUDES 5 IN. ABOVE GROUND.

### Comments:

FROM THE INTERSECTION OF BROCKWAY ROAD; CO. RD 47F; AND WILLIS CREEK RD; CO. RD 43; IN T28S R8W SEC.32; PROCEED SOUTHERLY ALONG WILLIS CREEK RD APPROX. 0.90 MILES TO MONUMENT ON RIGHT. MONUMENT IS BETWEEN A DRIVEWAY AND COUNTY RD NEAR TOP OF 3 FT TALL CUTBANK.

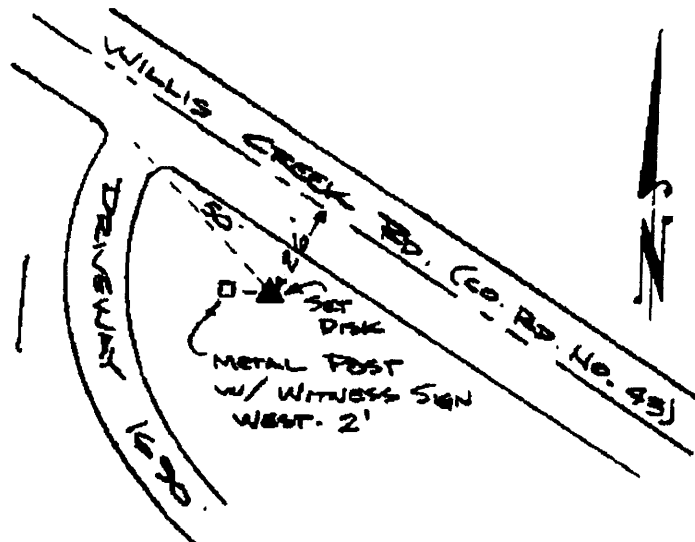

### Notes:

Note: For further information contact the Douglas County Surveyors Office, Room 105A Douglas County Courthouse, Roseburg, OR 97470. Phone 440-4272 or Fax (541)957-8150. Douglas County Residents outside Roseburg calling area, dial toll free 1-800-224-1619.