


OFFICE OF THE  
DOUGLAS COUNTY SURVEYOR

Station: SE COR.  
 Set By (Agency): DCSO  
 Date Set: 1957  
 Recovered By RS,SF  
 Date Recovered 8/14/84  
 Recovered By \_\_\_\_\_  
 Date Recovered \_\_\_\_\_  
 Recovered By \_\_\_\_\_  
 Date Recovered \_\_\_\_\_

T 28 S, R 8 W, Sec 10

500500

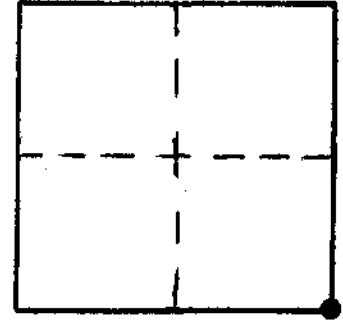

280-08W-10-011 285 08W 10  
SE CORNER

NAD 553141.70 4088080.01  
83 43° 8'31" 123°37'22"

VERTICAL CONTROL

Elevation: \_\_\_\_\_ NGS Line # \_\_\_\_\_ USGS Line # \_\_\_\_\_ OSHD Line # \_\_\_\_\_  
 Precision: \_\_\_\_\_ Agency: \_\_\_\_\_ Proj. # \_\_\_\_\_ Date: \_\_\_\_\_

HORIZONTAL CONTROL OCS 27

South Zone State Plane Coordinates: Y(Northing) 553,176.09 X(Easting) 1,167,121.28  
 Precision: 1/5,000 Agency: DCSO Proj. # 2004 Date: 1972  
 Approximate Geographic Position: Latitude 43°08'31" Longitude 123°37'17"

DESCRIPTION and TO REACH

SKETCH

Description:

A DCSO disk stamped " T28S R8W "  
 SEC  $\frac{10}{15} | \frac{11}{14}$   
 1957


set on a 1 3/8 " dia. I.P. protruding 9" in.  
above ground.

TO REACH:

From the intersection of Reston Rd. (Co. RD. #5) and  
 Coos Bay Wagon Rd. (Co. Rd. #112) in T28S, R8W, Sec. 14,  
 proceed westerly along Co. Rd. #112, 0.2 miles to a gravel  
 road on right, proceed northwesterly along gravel road  
 approx. 0.1 miles to a power line road, proceed northeasterly  
 along power line road approx. 0.15 miles, proceed northerly  
 on foot approx. 500 ft. to corner. \*

NOTE: See DCSO corner renewal records.

Reference Marks:

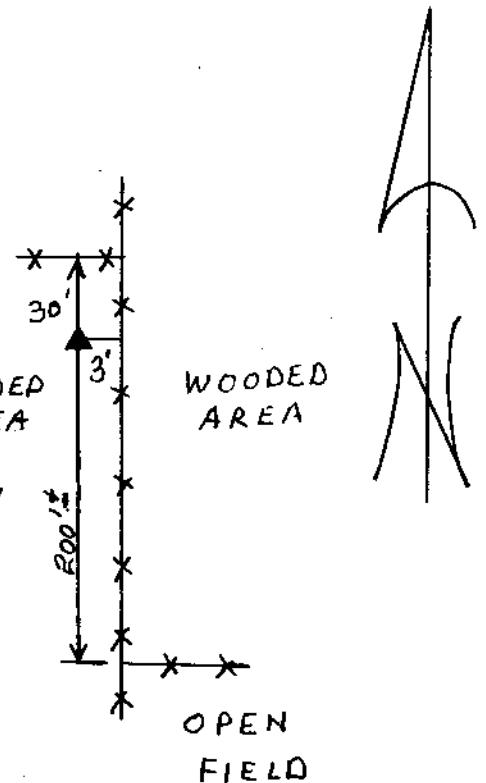

Note: For further information, contact the Douglas County Surveyor's Office, Room 205  
 Douglas County Justice Building, Roseburg, OR 97470. Phone 440-4278. Douglas  
 County residents outside the Roseburg calling area, dial toll free 1-800-452-0991.