

OFFICE OF THE  
DOUGLAS COUNTY SURVEYOR

Station: M74 T 29 S, R 5W, Sec 27

Date Set: 1991

Set By (Agency): City of M.C.

Date Recovered: 10/7/91



Recovered By: Ruppert LS 866

Date Recovered: \_\_\_\_\_

Recovered By: \_\_\_\_\_

Date Recovered: \_\_\_\_\_

Recovered By: \_\_\_\_\_

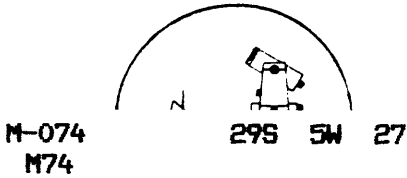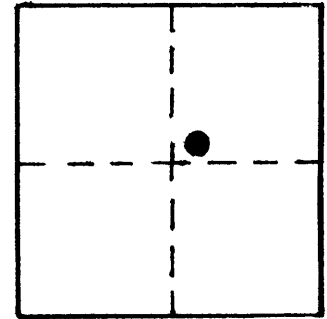

NAD 83 505674.43 4179540.46  
43° 1'14" 123°16'27"

VERTICAL CONTROL NGVD 29

Elevation: 638<sup>96</sup> NGS Line # \_\_\_\_\_ USGS Line # \_\_\_\_\_ OSHD Line # \_\_\_\_\_

Precision: 3<sup>rd</sup> Agency: PRIVATE Proj. # CS 63/136-5 Date: 1993

HORIZONTAL CONTROL

South Zone O.C.S. 27: Y(Northing) 505,710.03 X(Easting) 1,258,582.01

South Zone O.C.S. 83: Y(Northing) \_\_\_\_\_ X(Easting) \_\_\_\_\_

Precision: 1/15,000 Agency: DCSO Proj. # 2017-1 CS 64/22 Date: 1991


Approx. NAD 83 Geographic Position: Latitude 43° 01' 14" Longitude 123° 16' 23"

DESCRIPTION and TO REACH

SKETCH

Set: A standard DCSO disk stamped "M74 1991" set in concrete curbing.

To Reach: At the intersection of Myrtle View Dr. and Neal Ln. in Myrtle Creek.

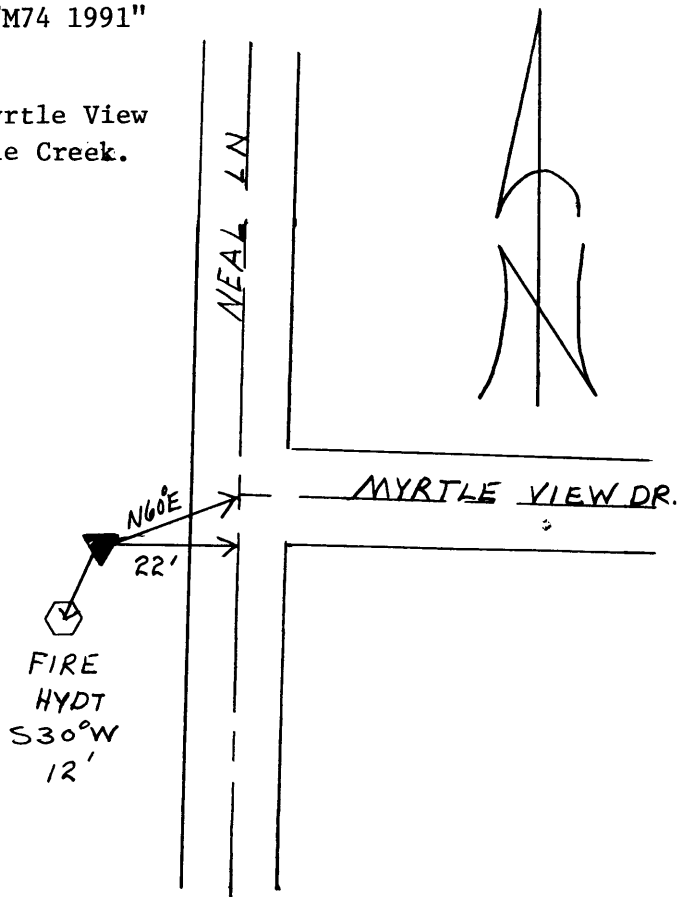

Reference Marks:

Note: For further information, contact the Douglas County Surveyor's Office, Room 205 Douglas County Justice Building, Roseburg, OR 97470. Phone 440-4278. Douglas County residents outside the Roseburg calling area, dial toll free 1-800-452-0991.