

OFFICE OF THE
DOUGLAS COUNTY SURVEYOR

Station: M84

T 29 S, R 5W , Sec 28

Date Set: 1991

Set By (Agency): City of M.C.

Date Recovered: 10/16/91


Recovered By: Ruppert LS 866

Date Recovered: _____

Recovered By: _____

Date Recovered: _____

Recovered By: _____

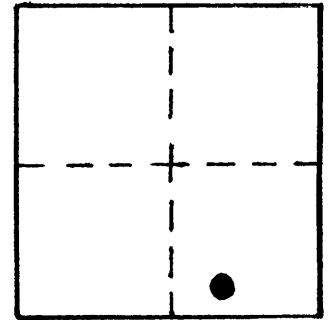

M-084
M84 295 5W 28

NAD 503524.74 4174506.90
83 43° 0'51" 123°17'34"

VERTICAL CONTROL **NGVD 29**

Elevation: 634.6 NGS Line # _____ USGS Line # _____ OSHD Line # _____

Precision: GPS Agency: DCSO Proj. # 2017-1 CS64/22 Date: 1991

HORIZONTAL CONTROL

South Zone O.C.S. 27: Y(Northing) 503,560.32 X(Easting) 1,253,548.46

South Zone O.C.S. 83: Y(Northing) _____ X(Easting) _____

Precision: 1/15,000 Agency: DCSO Proj. # 2017-1 CS 64/22 Date: 1991


Approx. NAD 83 Geographic Position: Latitude _____ Longitude _____

DESCRIPTION and TO REACH

SKETCH

Set: A standard DCSO disk stamped "M84 1991"
set in concrete curb.

To Reach: Mon. is set on south side Plaza Dr.
100 ft. east of the intersection of
South Main and Plaza Dr.

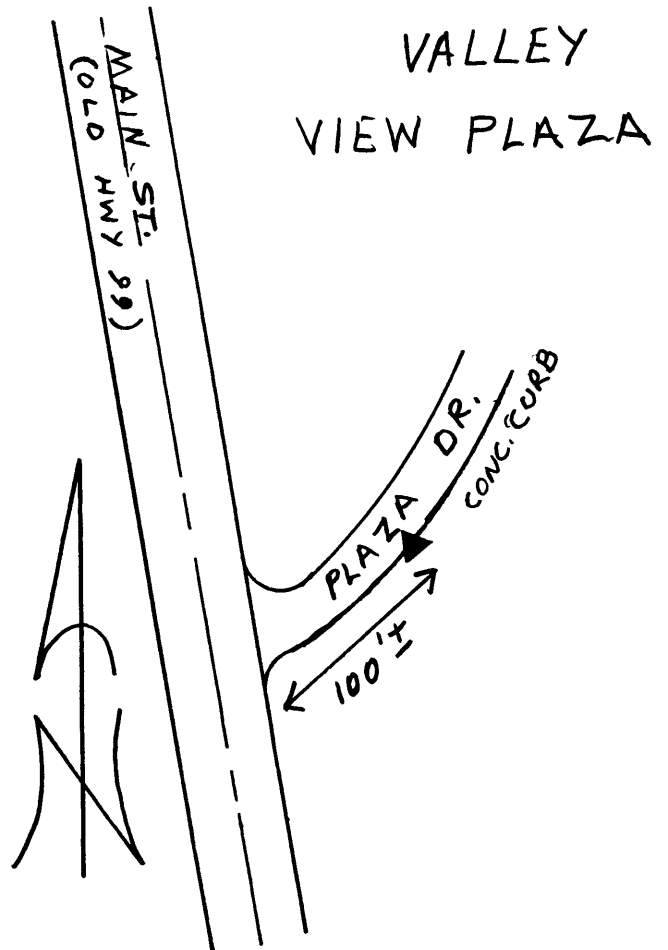

Reference Marks:

Note: For further information, contact the Douglas County Surveyor's Office, Room 205
Douglas County Justice Building, Roseburg, OR 97470. Phone 440-4278. Douglas
County residents outside the Roseburg calling area, dial toll free 1-800-452-0991.