


OFFICE OF THE
DOUGLAS COUNTY SURVEYOR

N-024 120 03 1
151 0005
NAE 055154.88 4126293.43
03 451 4157 123 423 84'

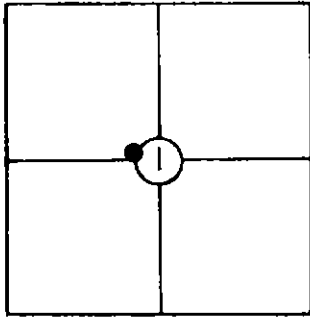

T 29 S, R 7W, Sec. 1

Station: TWO Oaks

Set By (Agency): USC & GS

Date: 1942

VERTICAL CONTROL

Elevation: 1734.3 NGS(USC&GS) ^{Book}~~Line~~ # 816 USGS Line # _____

Order
Of Precision V.A. Agency: DCSO Proj. #: 2002 Date: 1971

HORIZONTAL CONTROL

Oregon State Plane Coordinates: Y(Northing) 528,090.00 X(Easting) 1,205,335.76
(South Zone)


Order
Of Precision 1/100,000 Agency: DCSO Proj. #: 2002 Date: 1971

Approximate Geographic Position: Latitude= _____ Longitude= _____

DESCRIPTION: Located on a round topped butte

which is 0.5 mi. S. of a butte which is
slightly higher. Station monument is solid
and in ground. R.M. 1 is out of the ground
and needs to be replaced. R.M. 2 is in place
in the ground but loose.

SKETCH

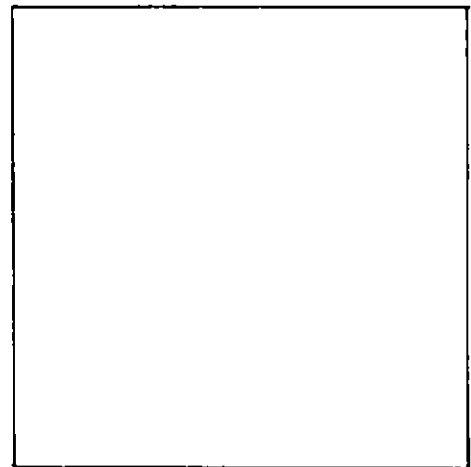

VICINITY: 11 mi. airline S.W. of Roseburg
3 mi. S. W. of Dillard.

NOTE: For Possible Further Information On This Station, Please Contact The Douglas County Surveyors Office, Rm. 205 Douglas County Justice Bldg., Roseburg, OR. 97470 Phone 672-3311 Ext. 272. Douglas County residents outside the Roseburg calling area dial toll free 1-800-452-0991.