


120446

290-07W-18-023 29S 07W 18  
C-W 1/16

OFFICE OF THE  
DOUGLAS COUNTY SURVEYOR

NAD 520031.12 4098895.69  
83 43° 3' 8" 123° 34' 39"

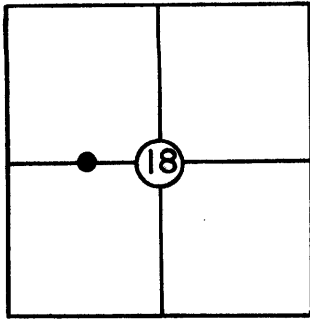

T 29 S, R 7W, Sec. 18  
Station: CW1/16S18 (see comments for name as platted)  
Set By (Agency): GLO  
Date: 1924

VERTICAL CONTROL

Elevation: \_\_\_\_\_ NGS(USC&GS) Line # \_\_\_\_\_ USGS Line # \_\_\_\_\_

Order  
Of Precision \_\_\_\_\_ Agency: \_\_\_\_\_ Proj. #: \_\_\_\_\_ Date: \_\_\_\_\_

HORIZONTAL CONTROL OCS 27

Oregon State Plane Coordinates: Y(Northing) 520,065.90 X(Easting) 1,177,937.77  
(South Zone) CS 59/41 A

Order  
Of Precision 1/10,000 Agency: DCSO Proj. #: 2010-3 Date: 1977

Approximate Geographic Position: Latitude= 43° 03' 08" Longitude= 123° 34' 35"


DESCRIPTION: I. pipe w/brass cap attached.

See Douglas County Surveyor's record of  
government corners renewed.

Comments: Name as shown on BLM plat

AP4  
TR50  
AP1  
TR51

SKETCH

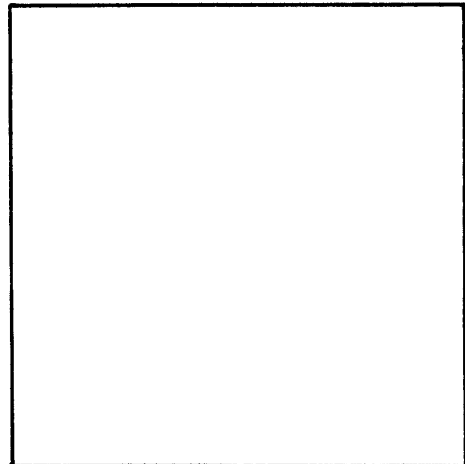

VICINITY: Olalla, Oregon

NOTE: For Possible Further Information On This Station, Please Contact The Douglas County Surveyors Office, Rm. 205 Douglas County Justice Bldg., Roseburg, OR. 97470 Phone 672-3311 Ext. 272.. Douglas County residents outside the Roseburg calling area dial toll free 1-800-452-0991.