

OFFICE OF THE
DOUGLAS COUNTY SURVEYOR




v-022
VIC

305 3W 26

NAD 474301.35 4244908.33
83 42°56'24" 123° 1'35"

Station: VIC. T 30 S, R 3W, Sec 26
Set By (Agency): DCSO
Date Set: 1975
Recovered By JP-RWS
Date Recovered 3-18-82
Recovered By RWS, S.J.F.
Date Recovered 8/14/85
Recovered By RWS - 5/29/98 FO OK
Date Recovered _____

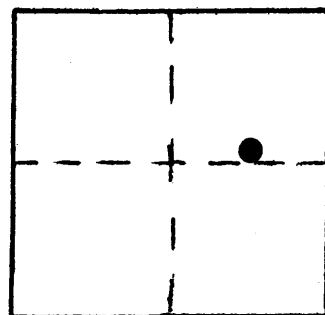

VERTICAL CONTROL NGVD 29

Elevation: 953.355 NGS Line # _____ USGS Line # _____ OSHD Line # _____
Precision: 2nd Agency: DCSO Proj. # 2010-2 Date: 1975

HORIZONTAL CONTROL OCS 27


South Zone State Plane Coordinates: Y(Northing) 474,337.54 X(Easting) 1,323,949.82
Precision: 1/25,000 Agency: DCSO Proj. # 2010-2 Date: 1975
Approximate Geographic Position: Latitude 42°56'25" Longitude 123°01'31"

DESCRIPTION and TO REACH

SKETCH

Found: A standard DCSO disk stamped "Vic 1975"
set in concrete filled hole in rock, flush with
the ground and approx. 10 ft. above the surface
of the road. Witness sign and post bear South
3 ft.

To reach: From the junction of State Hwy. 227
and BLM Rd. T30-3-26.0 (Corn Creek) proceed
Easterly 0.15 miles to station on the right
or the Southerly side of the road.

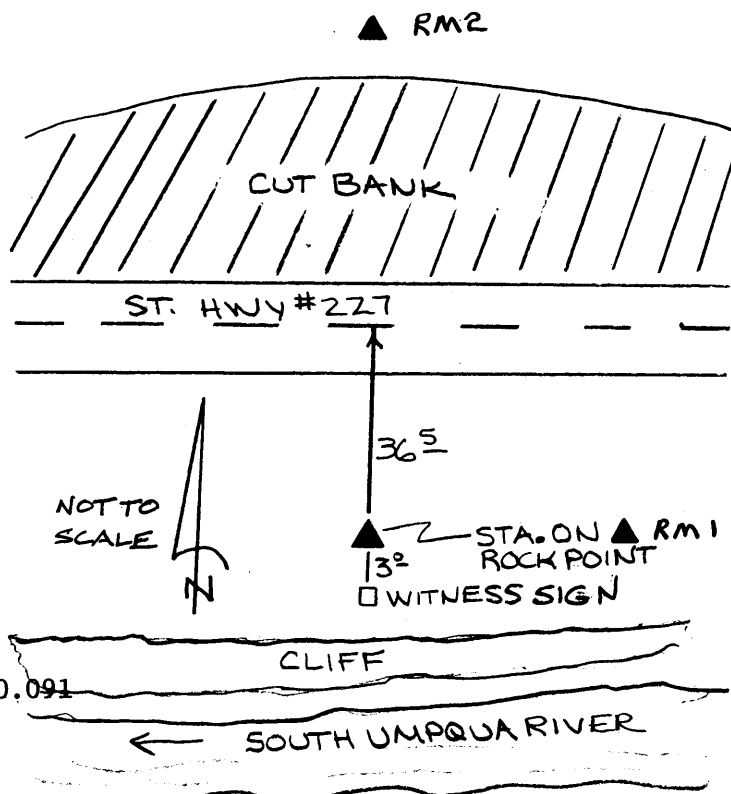

Reference Marks: (Proj. #2013)

A DCSO disk stamped "VIC RM 1 1985"
bears N89°03'04" E, 34.74 ft. (grid) elev. 950.091

~~A DCSO disk stamped "VIC RM 2 1985"~~
~~bears N 0°00'10" E, 91.60 ft. (grid).~~
RM 2 NOT FOUND 9/98

Note: For further information, contact the Douglas County Surveyor's Office, Room 205
Douglas County Justice Building, Roseburg, OR 97470. Phone 440-4278. Douglas
County residents outside the Roseburg calling area, dial toll free 1-800-452-0991.