

OFFICE OF THE
DOUGLAS COUNTY SURVEYOR




p-080
PTS-27

30S 5W 18

NAD 485446.32 4163605.59
83 42°57'49" 123°19'53"

Station: PTS-27 T 30 S, R 5W, Sec 18
Set By (Agency): DCSO
Date Set: 1978
Recovered By JP-RWS
Date Recovered 1-28-82
Recovered By _____
Date Recovered _____
Recovered By _____
Date Recovered _____

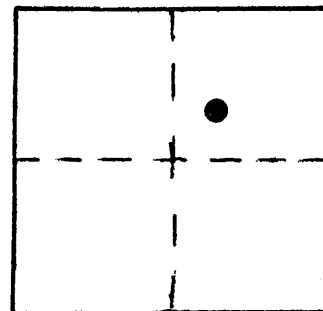

VERTICAL CONTROL

Elevation: _____ NGS Line # _____ USGS Line # _____ OSHD Line # _____
Precision: _____ Agency: _____ Proj. # _____ Date: _____

HORIZONTAL CONTROL OCS 27


South Zone State Plane Coordinates: Y(Northing) 485,482.01 X(Easting) 1,242,647.02
Precision: 1/25,000 Agency: DCSO Proj. # 2008 Date: 1978
Approximate Geographic Position: Latitude 42°57'49" Longitude 123°19'48"

DESCRIPTION and TO REACH

SKETCH

Found: A standard DCSO disk set in headwall
of underpass (used for cattle) and is stamped
"PTS-27 1978".

To reach: From Riddle exit #103 on I-5 proceed
southerly 0.7 miles to station on North side
of freeway.

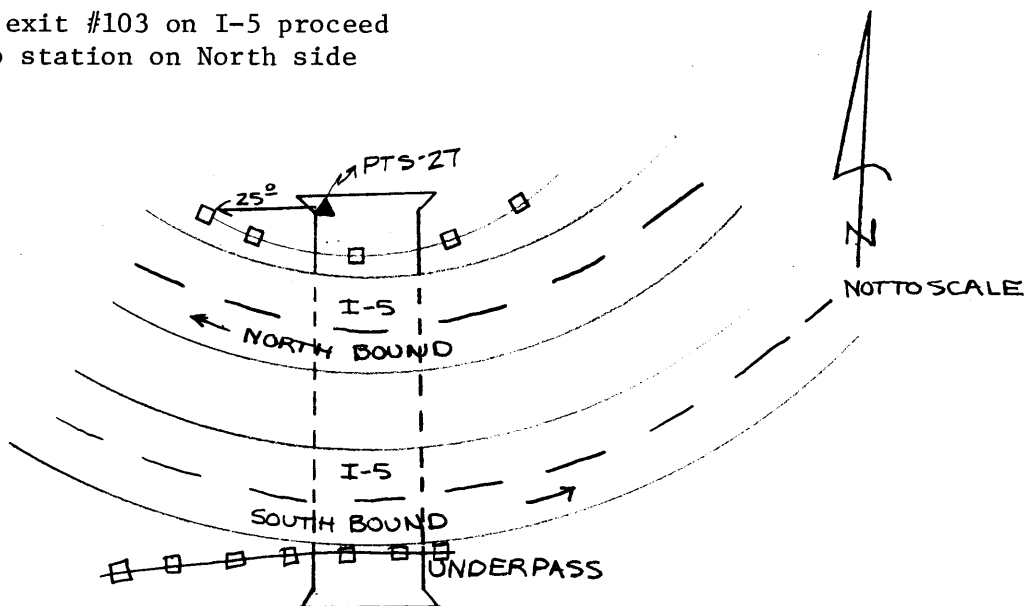

Reference Marks:

Note: For further information, contact the Douglas County Surveyor's Office, Room 205
Douglas County Justice Building, Roseburg, OR 97470. Phone 440-4278. Douglas
County residents outside the Roseburg calling area, dial toll free 1-800-452-0991.