

VERTICAL CONTROL CORPSCON 6 NAVD88 717.743 FT.

NGVD 29 Elevation: ~~713.952~~ FEET NAVD 88 Elevation: 218.768 METERS

NGS Line # 125042 USGS LINE # 6 OSHD Line # \_\_\_\_\_ FILE # \_\_\_\_\_

Precision: 1ST ORDER Agency: CGS Proj: \_\_\_\_\_ Date: 1988

HORIZONTAL CONTROL

O.C.S. 27 Y(Northing): 7 O.C.S. 83 Y(Northing): 404851

(South Zone) X(Easting): \_\_\_\_\_ (South Zone) X(Easting): 4156426


Precision: GIS SCALED Agency: DCSO Proj: \_\_\_\_\_ Date: 2014

Approx. O.C.S. 27 Geographic Position: Latitude: 42°57'41" Longitude: 123°21'23"

Approx. O.C.S. 83 Geographic Position: Latitude: \_\_\_\_\_ Longitude: \_\_\_\_\_

Found: A 3 - 1/2 inch diameter USC&GS disk stamped "E 499 1949" set flush in top of a 12 inch diameter concrete post, firmly set and protruding approx. 3 inches above ground.

To reach: From the intersection of Main St., Riddle (Co. Rd. #264) and Fifth Ave. (becomes Pruner Rd. (Co. Rd.#20), Riddle in T30S R6W Sec. 23, proceed northerly along Fifth Ave. (also Pruner Rd. (Co. Rd. #20) approx. 0.8 miles to monument on left. Monument is approx. 400 feet west of road on east edge of SPRR tracks.

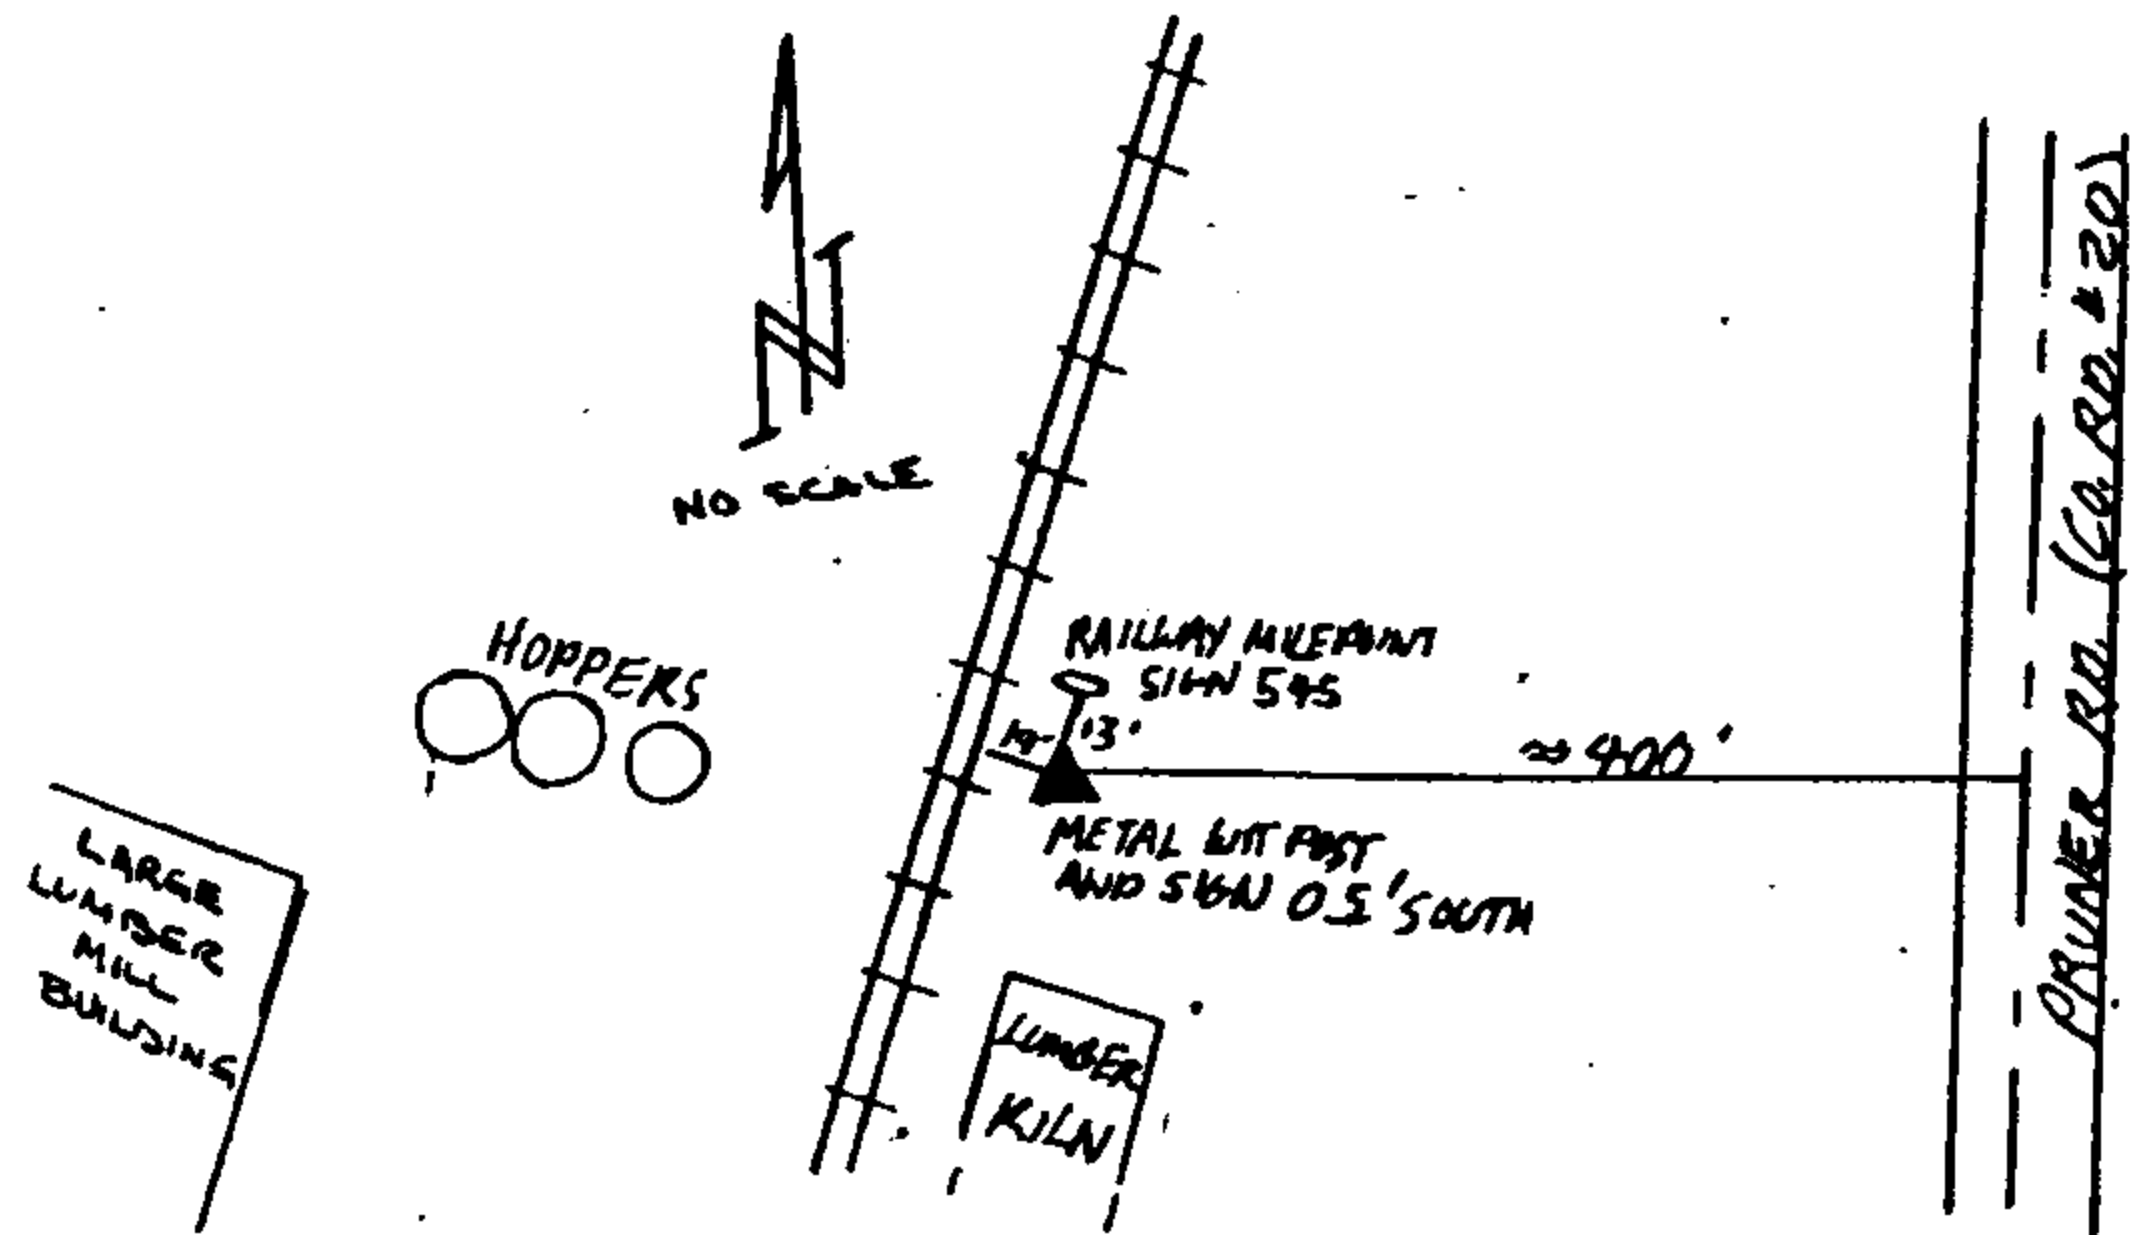

Note: For further information contact the Douglas County Surveyors Office, Room 205 Douglas County Justice Building, Roseburg, OR 97470. Phone 440-4272. Douglas County Residents outside Roseburg calling area, dial toll free 1-800-477-0991.