



OFFICE OF THE
DOUGLAS COUNTY SURVEYOR

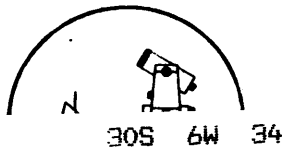

h-049
HUBBS

NAD 470351.04 4148186.84
83 42°55'15" 123°23'13"

Station: Hubbs T 30 S, R 6W , Sec 34
Set By (Agency): DCSO
Date Set: 1982
Recovered By LEM
Date Recovered 2-82
Recovered By _____
Date Recovered _____
Recovered By _____
Date Recovered _____
Recovered By _____
Date Recovered _____

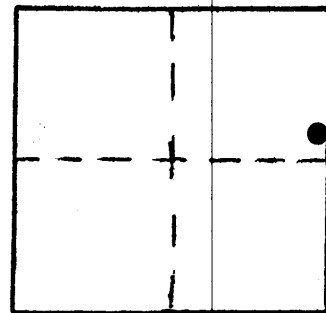

VERTICAL CONTROL

Elevation: _____ NGS Line # _____ USGS Line # _____ OSHD Line # _____
Precision: _____ Agency: _____ Proj. # _____ Date: _____

HORIZONTAL CONTROL *OCS 27*


South Zone State Plane Coordinates: Y(Northing) 470,386.70 X(Easting) 1,227,228.36
Precision: 1/25,000 Agency: DCSO Proj. # 2013 Date: 1982
Approximate Geographic Position: Latitude 42°55'15" Longitude 123°23'08"

DESCRIPTION and TO REACH

Set: A standard DCSO disk set in a 6" x 42" concrete tile filled with concrete and iron buried 40" into the ground. Station mark is approx. 2 1/2 ft. above road surface.

To reach: From the intersection of Co.Rd. #39 (Glenbrook Loop) and Co.Rd. #44 (Shoestring Rd.) in T30S R6W sec.26 proceed South on Co.Rd #44 0.75 miles to monument on the right.

SKETCH

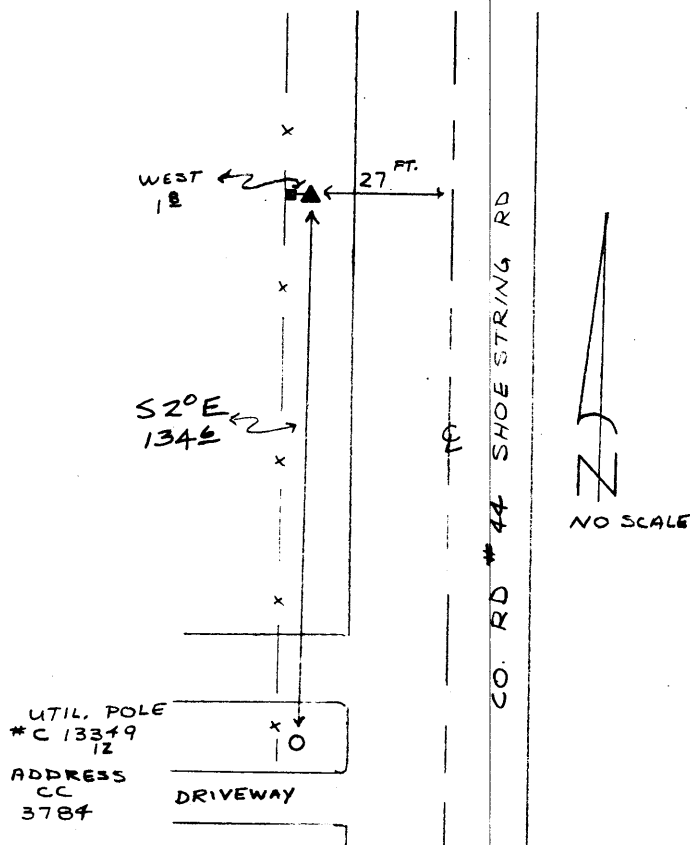

Reference Marks:

Note: For further information, contact the Douglas County Surveyor's Office, Room 205 Douglas County Justice Building, Roseburg, OR 97470. Phone 440-4278. Douglas County residents outside the Roseburg calling area, dial toll free 1-800-452-0991.