



OFFICE OF THE
DOUGLAS COUNTY SURVEYOR

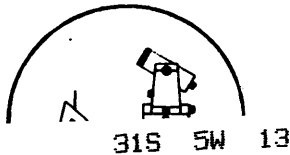

p-069
PTS-16

NAD 450577.81 4185164.58
83 42°52'12" 123°14'47"

Station: PTS-16 T 31 S, R 5 W , Sec 13
Set By (Agency): DCSO
Date Set: 1975
Recovered By JMP-RS
Date Recovered 1/82
Recovered By _____
Date Recovered _____
Recovered By _____
Date Recovered _____
Recovered By _____
Date Recovered _____

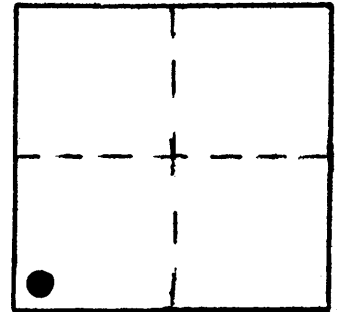

VERTICAL CONTROL

Elevation: _____ NGS Line # _____ USGS Line # _____ OSHD Line # _____
Precision: _____ Agency: _____ Proj. # _____ Date: _____

HORIZONTAL CONTROL *OCS 27*


South Zone State Plane Coordinates: Y(Northing) 450,613.87 X(Easting) 1,264,205.89
Precision: 1/25,000 Agency: DCSO Proj. # 2008 Date: 1975
Approximate Geographic Position: Latitude 42°52'12" Longitude 123°14'43"

DESCRIPTION and TO REACH

Station is a standard DCSO disk set in stone approx. 2" above the ground and stamped "PTS-16 1975".

To Reach: From the Canyon Creek Rd. overpass over I-5 in S.2 T31S, R5W, proceed southerly along I-5 2.5 mi. to the station on the right, approx. 30' above the southbound lane of I-5.

SKETCH

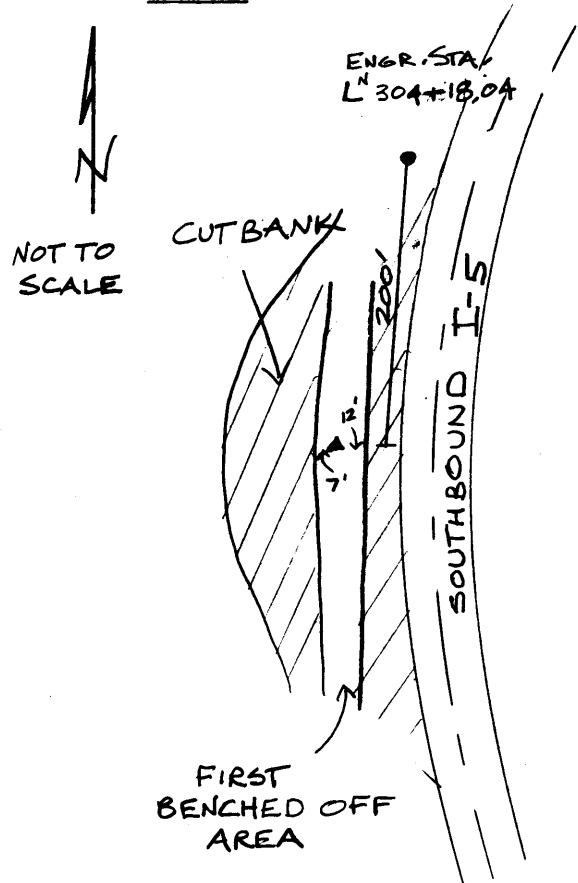

Reference Marks:

Note: For further information, contact the Douglas County Surveyor's Office, Room 205 Douglas County Justice Building, Roseburg, OR 97470. Phone 440-4278. Douglas County residents outside the Roseburg calling area, dial toll free 1-800-452-0991.