
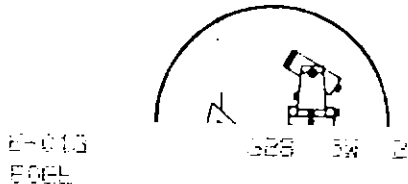


OFFICE OF THE
DOUGLAS COUNTY SURVEYOR

Station: EDGE T 32 S, R 5 W , Sec 2
Set By (Agency): USC&GS
Date Set: 1962
Recovered By JP,RS
Date Recovered 9/12/83
Recovered By _____
Date Recovered _____
Recovered By _____
Date Recovered _____

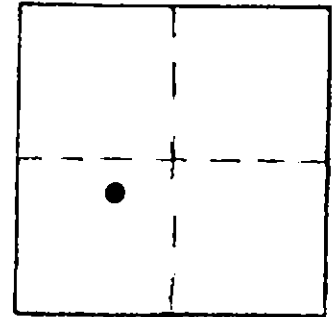

E-013
E06L

NAD 431600.98 431817.60
SS 42°49' S 123°15' W

VERTICAL CONTROL

Elevation: _____ NGS Line # _____ USGS Line # _____ OSHD Line # _____
Precision: _____ Agency: _____ Proj. # _____ Date: _____

HORIZONTAL CONTROL

South Zone State Plane Coordinates: Y(Northing) 431,637.13 X(Easting) 1,259,608.91
Precision: 1/25,000 Agency: DCSO Proj. # 2008 Date: 1975
Approximate Geographic Position: Latitude 42°49'03" Longitude 123°15'36"

DESCRIPTION and TO REACH

SKETCH

DESCRIPTION:


A disk stamped "EDGE USC&GS 1962" set
on a 2 1/2 in. diam. I.P., protruding
6 in. out of a concrete post.

TO REACH:

From the intersection of I-5 and Co.Rd. #36
(Upper Cow Creek Rd. exit #88) in T32S,R5W,
Sec.11, proceed northerly along I-5 1.8 miles
to monument on left.

* Monument is approx. at Engineering Sta. LN 515+64.

* Monument appears to have been disturbed.

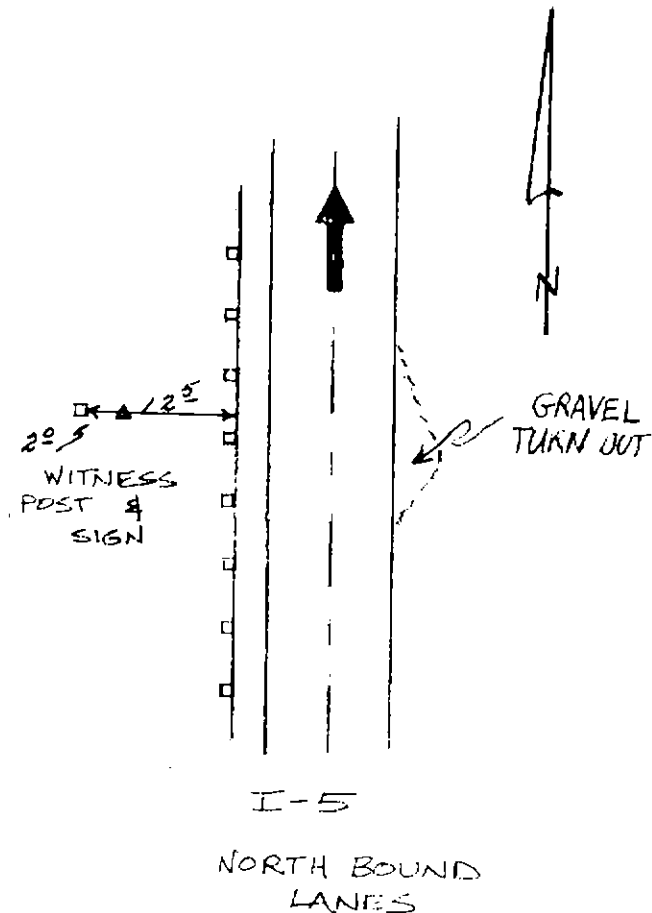

Reference Marks:

Note: For further information, contact the Douglas County Surveyor's Office, Room 205
Douglas County Justice Building, Roseburg, OR 97470. Phone 440-4278. Douglas
County residents outside the Roseburg calling area, dial toll free 1-800-452-0991.