


OFFICE OF THE
DOUGLAS COUNTY SURVEYOR



p-002 32S 5W 2
PT 491 + 53.52

RAD 434043.14 4130411.07
BS 42°49'27" 123°15'34"

Station: PT 491+53.52 T 32 S, R 5 W , Sec 2
Set By (Agency): OSHD
Date Set: ?
Recovered By RS,JP
Date Recovered 9/15/83
Recovered By _____
Date Recovered _____
Recovered By _____
Date Recovered _____

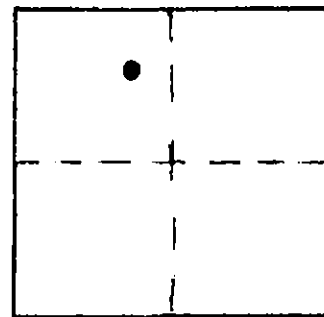

VERTICAL CONTROL

Elevation: _____ NGS Line # _____ USGS Line # _____ OSHD Line # _____
Precision: _____ Agency: _____ Proj. # _____ Date: _____

HORIZONTAL CONTROL

South Zone State Plane Coordinates: Y(Northing) 434,043.30 X(Easting) 1,259,853.02
Precision: 1/25,000 Agency: DCSO Proj. # 2008 Date: 1975
Approximate Geographic Position: Latitude 42°49'27" Longitude 123°15'34"

DESCRIPTION and TO REACH


SKETCH

DESCRIPTION:

A OSHD disk stamped "25 PT491+53.52" set
in a 6 in. square concrete post flush
with ground.

TO REACH:

From the intersection of I-5 and Co. Rd. #36
(Upper Cow Creek Rd. exit #88) in T32S,R5W,Sec.11,
proceed northerly along I-5 1.8 miles to monument
on left.

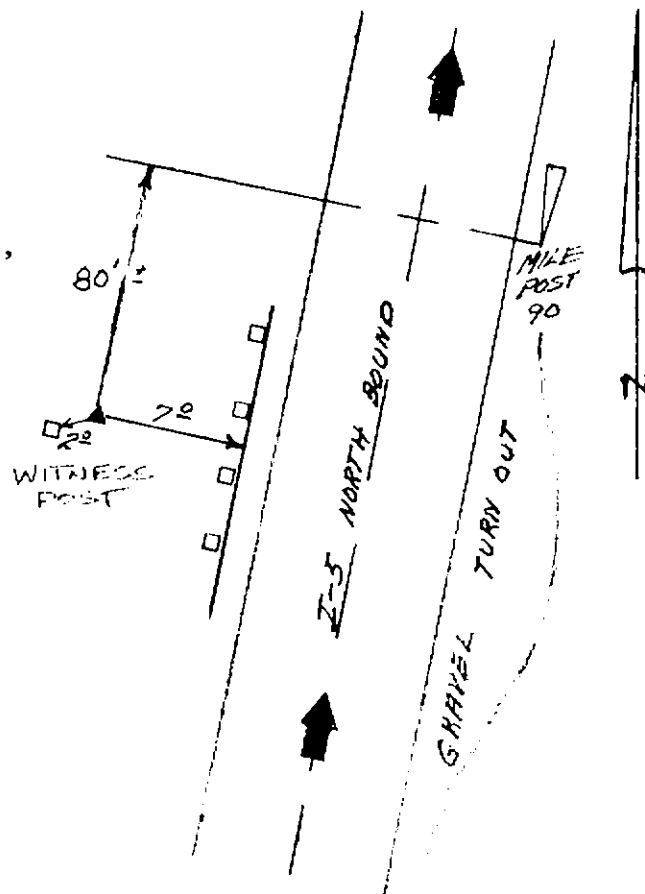

Reference Marks:

Note: For further information, contact the Douglas County Surveyor's Office, Room 205
Douglas County Justice Building, Roseburg, OR 97470. Phone 440-4278. Douglas
County residents outside the Roseburg calling area, dial toll free 1-800-452-0991.