


OFFICE OF THE
DOUGLAS COUNTY SURVEYOR



S-023 215 10W 5
S-20

NAD 788096.73 4020414.77
83 43°46'43" 123°54'43"

Station: S-20 T 21 S, R 10W, Sec 5
Set By (Agency): DCSO
Date Set: 1973
Recovered By LEM
Date Recovered 1-82
Recovered By _____
Date Recovered _____
Recovered By _____
Date Recovered _____
Recovered By _____
Date Recovered _____

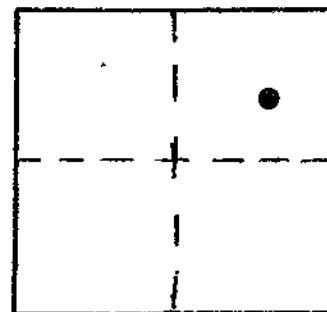

VERTICAL CONTROL

Elevation: 57.177 NGS Line # _____ USGS Line # _____ OSHD Line # _____
Precision: 2nd Agency: DCSO Proj. # 2006 Date: 1973

HORIZONTAL CONTROL

South Zone State Plane Coordinates: Y(Northing) 788,132.36 X(Easting) 1,099,454.34
Precision: 1/25,000 Agency: DCSO Proj. # 2006 Date: 1973
Approximate Geographic Position: Latitude 43°46'44" Longitude 123°54'38"

DESCRIPTION and TO REACH

SKETCH

Found: A standard DCSO disk set flush with the ground in a boulder. Monument is approx. 1½ ft. lower than asphalt level and 6 ½ ft. West of Westerly pavement edge.

To reach: From the intersection of Co.Rd. #48 (North Fork Smith River) and Smith River Rd. in T20S R10W sec. 31. Proceed easterly along Smith River Rd. 2.0 miles to monument on the right.

